

WAYNE
091
5-68

MISSISSIPPI
BOARD OF WATER COMMISSIONERS
416 North State Street
Jackson, Mississippi 39201

CODED

WATER WELL DRILLERS LOG

5-11 1968 date well completed
Car's water well service firm name
Wayne county well located

LANDOWNER: Mr. T.A. Brett
Denham Rd
Rt 4 waynesboro Miss (mailing address)

description of formations encountered	from	to
Red sand	0	15
med yellowish sand	15	25
fine gravel	25	30
med white sand	30	40
fine yellowish sand	40	45
med white sand	45	50
fine white sand	50	55
med yellowish sand	55	57
Gravel	57	60
Coarse white sand	60	66
Fine white sand	66	68

WELL LOCATION:
sec. 13 T. 6 S. R. 6 E. W. 4
1/4 miles NNW of Denham (distance) (direction) (nearest town)

WELL PURPOSE: Home (home, irrigation, municipal, industrial)


WELL COMPLETION DATA:
(1) diameter (inches) 2"
(2) total depth (feet) 68'
(3) static water level (feet) 46" (below top of ground)
(4) casing Galv. 63' (material) (depth)
If telescope see back.
(5) screen 4' 63' (size) (length) (depth to top)
2" Stain Less steel (size) (material)
(6) pump 1 7 (HP) (yield gpm)
Elect (type power)
(7) electric log (yes or no)
(organization running log)
(8) how well bottom plugged 1/4" B.W. Valve

DRILLERS REMARKS:

WAYNE
MISSISSIPPI
MAY 1968

If well telescopes please sketch and show depths.

GROUND LEVEL

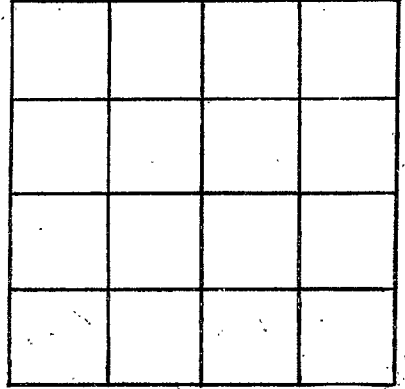

SECTION _____

Please indicate well location X.

ADDITIONAL INFORMATION

If more than one screen, show locations of each on sketch.