

Wayne  
 D92  
 10-1-68

MISSISSIPPI  
 BOARD OF WATER COMMISSIONERS  
 416 North State Street  
 Jackson, Mississippi 39201

CODED

WATER WELL DRILLERS LOG

Oct 1, 1968 date well completed  
 P. D. Drilling & Service firm name  
 Wayne county well located

LANDOWNER: Labony Hospital  
Church  
Waynesboro, Miss  
 (mailing address)

description of formations encountered	from	to
...	0	12
...	19	26
...	26	33
...	33	64
...	64	100
...	100	136
...	136	147
...	147	160
...	160	190

WELL LOCATION:  
 sec. 6 T. 80 N. R. 6 E. S. 1 W.  
1 miles NE of Waynesboro  
 (distance) (direction) (nearest town)

WELL PURPOSE: drinking  
 (home, irrigation, municipal, industrial)

WELL COMPLETION DATA:

(1) diameter (inches) 2"

(2) total depth (feet) 190'

(3) static water level (feet) 113 <sup>below</sup>/<sub>above</sub> top of ground.

(4) casing steel 141'  
 (material) (depth)  
2"  
 (size) if telescope see back.

(5) screen ...  
 (length) (depth to top)  
 (size) (material)

(6) pump 2 7 1/2  
 (HP) (yield gpm)  
also  
 (type power)

(7) electric log no  
 (yes or no)  
 (organization running log)

(8) how well bottom plugged ...

CODED


OCT 14 1968

MISS. BU. OF  
 WATER COMMISSIONERS

DRILLERS REMARKS:

If well telescopes please sketch and show depths.

GROUND LEVEL

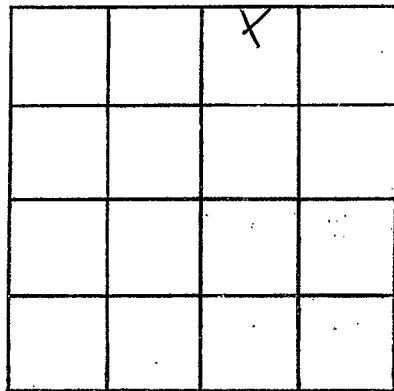

SECTION 6

Please indicate well location X.

ADDITIONAL INFORMATION

If more than one screen, show locations of each on sketch.