

Wayne
093
9-20-68

MISSISSIPPI
BOARD OF WATER COMMISSIONERS
416 North State Street
Jackson, Mississippi 39201

CODED

WATER WELL DRILLERS LOG

Sept 20 1968 *Port Drilling Co* Wayne
date well completed firm name county well located

LANDOWNER: *Richard Williams*
Williams
214 21 *miss*
(mailing address)

description of formations encountered	from	to
<i>sand clay</i>	<i>0</i>	<i>12</i>
<i>clay</i>	<i>12</i>	<i>53</i>
<i>shale</i>		<i>53</i>

WELL LOCATION:
sec. 17 T. 26 N. R. 6 E
S. 2 miles SE of 22 W
(distance) (direction) (nearest town)

WELL PURPOSE: *drinking*
(home, irrigation, municipal, industrial)

- WELL COMPLETION DATA:
- (1) diameter (inches) 2"
 - (2) total depth (feet) 52
 - (3) static water level (feet) 32 (below/above top of ground)
 - (4) casing steel, 47' (material) (depth)
2' if telescope see back. (size)
 - (5) screen 5', 47' (length) (depth to top)
1/2", galv. S.S. (size) (material)
 - (6) pump 3/4 (HP) 3 (yield gpm)
elec (type power)
 - (7) electric log no (yes or no)
(organization running log)
 - (8) how well bottom plugged check

CODED


OCT 14 1968

MISS. BD. OF
WATER COMMISSIONERS

DRILLERS REMARKS:

If well telescopes please sketch and show depths.

GROUND LEVEL

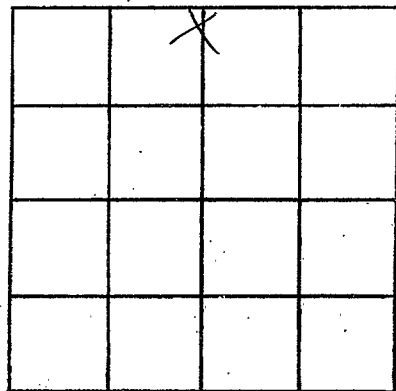

SECTION 17

Please indicate well location X.

ADDITIONAL INFORMATION

If more than one screen,
show locations of each on sketch.