

WAYNE
096
11-27-68

MISSISSIPPI
BOARD OF WATER COMMISSIONERS
416 North State Street
Jackson, Mississippi 39201

CODED

WATER WELL DRILLERS LOG

Nov 27 1968 Procter 10 Milling & Log Wayne
date well completed firm name county well located

LANDOWNER: Wanda's Clark
for Bobby Branch
Station St. Haysboro, Miss.
(mailing address)

description of formations encountered	from	to
entire	0	15
blue chert	15	41
red chert	41	50
blue chert	50	67
red chert	67	82
blue chert	82	88
fine blue sand	88	92
light white		
all in sand		
well pipe to		

WELL LOCATION:
18 ~~sec~~ T 8 N R 6 E
1 miles SE of Waynesboro
(distance) (direction) (nearest town)

WELL PURPOSE: Home
(home, irrigation, municipal, industrial)

WELL COMPLETION DATA:

- (1) diameter (inches) 2"
- (2) total depth (feet) 99'
- (3) static water level (feet) 51' below above top of ground.
- (4) casing steel, 92'
(material) (depth)
2" if telescope see back.
(size)
- (5) screen 6', 93'
(length) (depth to top)
1/2", 80m S.S.
(size) (material)
- (6) pump 3/4, 7 1/2
(HP) (yield gpm)
elec
(type power)
- (7) electric log no
(yes or no)

(organization running log)
- (8) how well bottom plugged
flush point


DRILLERS REMARKS:

CODED

DEC - 9 1968
MISS. Bd. OF WATER CONTROL

If well telescopes please sketch and show depths.

GROUND LEVEL

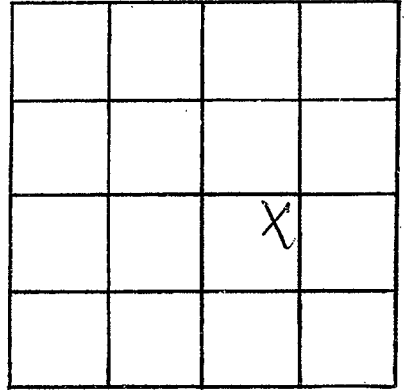

SECTION 18

Please indicate well location X.

ADDITIONAL INFORMATION

If more than one screen,
show locations of each on sketch.