

(2 Logs in one)

Clack record shows that name is es. was north pipe line es sat line
Boyl 3915
Pulley
10/28/68 JCR.
miss drilled

Wayne
0 97 & 98
11-21-68

MISSISSIPPI
BOARD OF WATER COMMISSIONERS

416 North State Street
Jackson, Mississippi 39201

WATER WELL DRILLERS LOG

CODED
CODED

11/21 1967 C. J. Clark Wayne
date well completed firm name county well located

LANDOWNER: Fonghaif Forest Products Co
Waynesboro, Miss
(mailing address)

description of formations encountered	from	to
Clay	0	8
Course Sand	8	21
Blue Clay	21	99
fine Sand & Clay mix	99	117
Blue Clay	117	159
Rock	159	166
Rock - Shells & Clay	166	240

WELL LOCATION:
sec. 18 T. 3(N) R. 6 E
S 5 W 1
1/2 miles SE of Waynesboro
(distance) (direction) (nearest town)

WELL PURPOSE: ind.
(home, irrigation, municipal, industrial)

WELL COMPLETION DATA:

- (1) diameter (inches) 4
- (2) total depth (feet) 240
- (3) static water level (feet) 30 below above top of ground.
- (4) casing Galvalume 160
(material) (depth)
- _____ if telescope see back.
(size)
- (5) screen None
(length) (depth to top)
- _____ (size) (material)
- (6) pump 3HP 35
(HP) (yield gpm)
3 Phase 440V
(type power)
- (7) electric log No
(yes or no)
- _____ (organization running log)
- (8) how well bottom plugged open


CODED

DRILLERS REMARKS:

NOTE
2 wells were drilled
375 ft apart the logs
pumps, water level etc. are the same on both wells

If well telescopes please sketch and show depths.

GROUND LEVEL

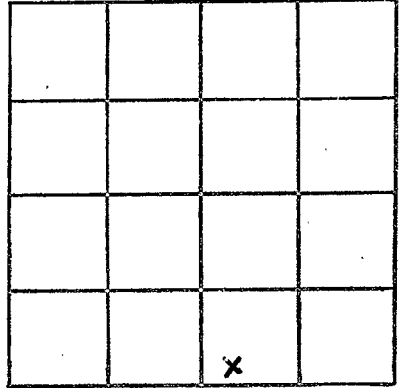

SECTION 18

Please indicate well location X.

ADDITIONAL INFORMATION

If more than one screen, show locations of each on sketch.