

Wayne  
099  
10-16-68

MISSISSIPPI  
BOARD OF WATER COMMISSIONERS  
416 North State Street  
Jackson, Mississippi 39201

CODED

WATER WELL DRILLERS LOG

CODED

Oct. 16 1968 date well completed  
Doris Water Well Drilling Co. name  
Wayne county well located  
Shelby Co. Pt.

LANDOWNER: Jame McInnis  
4 Waynesboro, Miss  
Pt. 2  
(mailing address)


description of formations encountered	from to	
	feet	feet
<u>Sandstone Band</u>	<u>0</u>	<u>23</u>
<u>Bibia Clay</u>	<u>23</u>	<u>128</u>
<u>Hammond Rock + Shales</u>	<u>120</u>	<u>150</u>

WELL LOCATION:  
sec 5 T 8 N R 6 E  
3 1/2 miles E of Waynesboro  
(distance) (direction) (nearest town)

WELL PURPOSE:  
(home, irrigation, municipal, industrial)

- WELL COMPLETION DATA:
- diameter (inches) 2 in
  - total depth (feet) 150
  - static water level (feet) 40 below top of ground.
  - casing Galv. 105  
(material) (depth)  
(size) if telescope see back.
  - screen Used none  
(length) (depth to top)  
(size) (material)
  - pump 1 HP 14  
(HP) (yield gpm)  
110 S.P.  
(type power)
  - electric log No  
(yes or no)  
(organization running log)
  - how well bottom plugged Open end

CODED

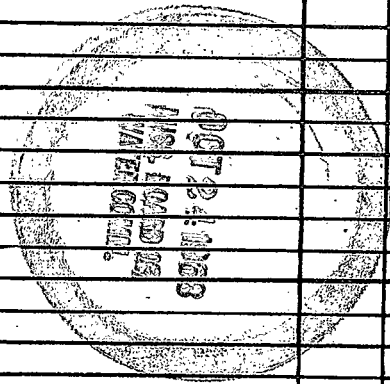

DRILLERS REMARKS:

If well telescopes please sketch and show depths.

GROUND LEVEL

			X

SECTION 5

Please indicate well location X.

ADDITIONAL INFORMATION

If more than one screen, show locations of each on sketch.