

Wayne  
 O 102  
 1-18-69

MISSISSIPPI  
 BOARD OF WATER COMMISSIONERS  
 416 North State Street  
 Jackson, Mississippi 39201

CODED  
 CODED

WATER WELL DRILLERS LOG

Jan 18 19 69 Porter Drilling & Log Wayne  
 date well completed firm name county well located

LANDOWNER: Jimmy Bushy

| description of formations encountered | from | to |
|---------------------------------------|------|----|
| rest of                               | 0    | 9  |
| Chalk & sand                          | 9    | 30 |
| Course white sand                     | 30   | 63 |
| Course red sand                       | 63   | 68 |
| more white sand                       | 68   | 74 |
| shale & white sand                    |      |    |
| in sand                               |      |    |

Box 4 Wayneboro, Miss  
 (mailing address)

WELL LOCATION:  
 sec. 13 T 8 N R 6 E  
6 miles east of Waynesboro  
 (distance) (direction) (nearest town)

WELL PURPOSE: Home  
 (home, irrigation, municipal, industrial)

WELL COMPLETION DATA:

- (1) diameter (inches) 2"
- (2) total depth (feet) 74
- (3) static water level (feet) 54 below top of ground.
- (4) casing steel, 68' (material) (depth)  
2" if telescope see back. (size)
- (5) screen 1', 68 (length) (depth to top)  
1 1/4" 60 gal S.S. (size) (material)
- (6) pump 3/4, 7 1/2 (HP) (yield gpm)  
elec (type power)
- (7) electric log no (yes or no)

6' 1 1/2" 60 gal SS screen  
on end of cas. with  
shut funnel to float back  
in cas. water  
6 3/4" 1 1/4" down pipe

(organization running log)


(8) how well bottom plugged shut sand

DRILLERS REMARKS:

FEB - 1969  
 MISS. D.O. #25  
 OFFICE OF THE

If well telescopes please sketch and show depths.

GROUND LEVEL

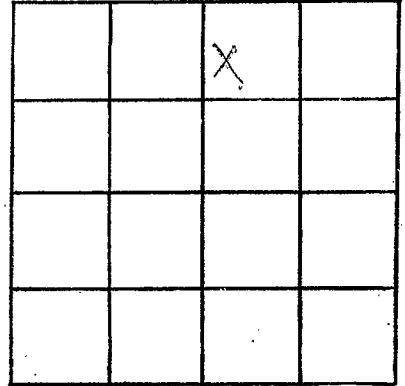

SECTION 13

Please indicate well location X.

ADDITIONAL INFORMATION

If more than one screen,  
show locations of each on sketch.