

Wayne Co  
 Ø 103  
 6-68

MISSISSIPPI  
 BOARD OF WATER COMMISSIONERS  
 416 North State Street  
 Jackson, Mississippi 39201

CODED

CODED

WATER WELL DRILLERS LOG

June 27, 1968 NEIL LUMPKIN WELL DRILLING COMPANY  
 P. O. BOX 117  
 CANTON, MISS. Hinds County Mississippi county well located

LANDOWNER: St. Regis Paper Co

description of formations encountered	from	to
Surface sand	0	19
Clay	19	100
Sand	100	115
Rocks & Shale	115	380
Fair sand	380	426

(mailing address)

WELL LOCATION:  
 sec 29 T 8 N R 6 E  
 N miles South of Wayne Co  
 (distance) (direction) (nearest town)

WELL PURPOSE: paper wood yard  
 (home, irrigation, municipal, industrial)

WELL COMPLETION DATA:


- (1) diameter (inches) 2"
- (2) total depth (feet) 426'
- (3) static water level (feet) 4' below top of ground.
- (4) casing galv. 421' (material), (depth)  
 2" (size) if telescope see back.
- (5) screen 5' (length), (depth to top)  
 2" St. Steel (size), (material)
- (6) pump 1/2 400 gal/hr. (HP), (yield gpm)  
 electric (type power)
- (7) electric log no. (yes or no)
- (organization running log)
- (8) how well bottom plugged Johnson  
 B.P. Palmer

DRILLERS REMARKS:

CODED  
 CODED  
 MISSISSIPPI WATER COMMISSIONERS  
 JUN 25 1968

If well telescopes please sketch and show depths.

GROUND LEVEL

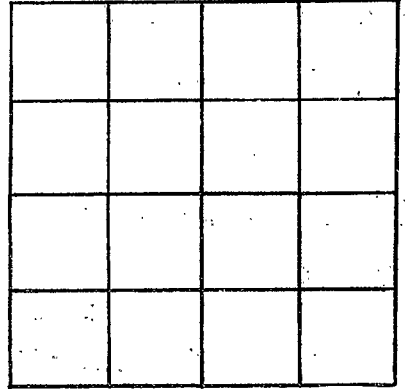

SECTION \_\_\_\_\_

Please indicate well location X.

ADDITIONAL INFORMATION

If more than one screen, show locations of each on sketch.