

WAYNE
D 104
1-24-69

MISSISSIPPI
BOARD OF WATER COMMISSIONERS
416 North State Street
Jackson, Mississippi 39201

WATER WELL DRILLERS LOG

1-24 1969 Dozier Well Service Wayne County
date well completed firm name county well located

LANDOWNER: SAM Jones

description of formations encountered	depth	
	from	to
Surface sand	0	20
Blue shale	20	60
Sand	60	80

Rt # 1
Waynesboro Miss
(mailing address)

WELL LOCATION:
sec. 6 T. 8 N. R. 6 E. W. 4
(distance) miles (direction) of (nearest town) WAYNESBORO

WELL PURPOSE: Home
(home, irrigation, municipal, industrial)

WELL COMPLETION DATA:

- (1) diameter (inches) 2
- (2) total depth (feet) 80
- (3) static water level (feet) 40 below top of ground
- (4) casing Gal. 80 (material) (depth)
- (5) screen SA 80 (length) (depth to top)
Dur. Steel (size) (material)
- (6) pump 1 12 (HP) (yield gpm)
Elec (type power)
- (7) electric log NO (yes or no)

CODED

MAR 21 1969

MISS. BD. OF WATER COMMISSIONERS


(organization running log)

(8) how well bottom plugged B.W

DRILLERS REMARKS:

If well telescopes please sketch and show depths.

GROUND LEVEL

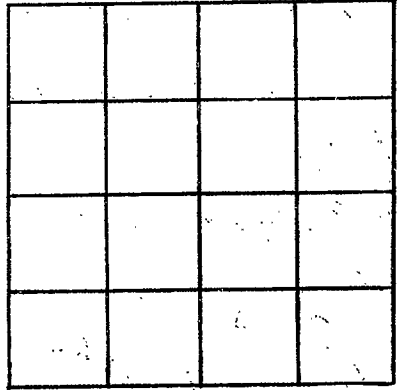

SECTION _____

Please indicate well location X.

ADDITIONAL INFORMATION

If more than one screen, show locations of each on sketch.