

**MISSISSIPPI  
BOARD OF WATER COMMISSIONERS**  
416 North State Street  
Jackson, Mississippi 39201

**WATER WELL DRILLERS LOG**

Wayne  
0107  
4-69

April 19 69 Peoples Drilling Co Wayne  
date well completed firm name county well located

LANDOWNER: Daniel Jones

description of formations encountered	from	to
<u>Yellow Sandy clay</u>	<u>0</u>	<u>28</u>
<u>Yellow sand</u>	<u>28</u>	<u>47</u>
<u>White sand</u>	<u>47</u>	<u>90</u>

RFD

Waynesboro, Miss  
(mailing address)

WELL LOCATION:  
sec 27 T. 8N R. 6E  
5 1/2 miles SE of Waynesboro  
(distance) (direction) (nearest town)

WELL PURPOSE: HOME  
(home, irrigation, municipal, industrial)

- WELL COMPLETION DATA:
- (1) diameter (inches) 2
  - (2) total depth (feet) 90
  - (3) static water level (feet) 43 below top of ground.
  - (4) casing galv. 84'  
(material) (depth)  
2 if telescope see back.  
(size)
  - (5) screen 6' 84'  
(length) (depth to top)  
2" Brass  
(size) (material)
  - (6) pump 1/2 3  
(HP) (yield gpm)  
elec  
(type power)
  - (7) electric log no  
(yes or no)

(organization running log)

(8) how well bottom plugged Back  
With water


DRILLERS REMARKS:

**MAY 20 1969**

MISS. BD. OF  
WATER COMM.

If well telescopes please sketch and show depths.

GROUND LEVEL

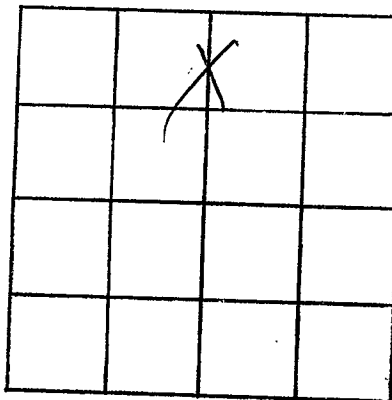

SECTION 27

Please indicate well location X.

ADDITIONAL INFORMATION

If more than one screen,  
show locations of each on sketch.