

MISSISSIPPI
BOARD OF WATER COMMISSIONERS
416 North State Street
Jackson, Mississippi 39201

CODED

WATER WELL DRILLERS LOG

Wayne
0108
5-21-69

May 21 1969 Porter Drilling & Pumping Wayne
date well completed firm name county well located

LANDOWNER	description of formations encountered	from	to
<u>U. K. Nicholas</u> <u>At 4 Waynesboro, Miss.</u> (mailing address)	<u>sand & chalk</u>	<u>0</u>	<u>12</u>
	<u>Coarse sand</u>	<u>12</u>	<u>69</u>
	<u>blue chalk</u>	<u>69</u>	<u>73</u>
	<u>med sand</u>	<u>73</u>	<u>91</u>
	<u>striped white shell in sand</u>		
WELL LOCATION: sec. <u>33</u> T. <u>80</u> N. R. <u>6</u> E. <u>4</u> miles S.E. of <u>Waynesboro</u> (distance) (direction) (nearest town)			
WELL PURPOSE: <u>none</u> (home, irrigation, municipal, industrial)			
WELL COMPLETION DATA:			
(1) diameter (inches) <u>2"</u>			
(2) total depth (feet) <u>71</u>			
(3) static water level (feet) <u>21</u> below top of ground.			
(4) casing <u>steel</u> <u>84'</u> (material) (depth) <u>2"</u> if telescope see back. (size)			
(5) screen <u>5'</u> <u>86'</u> (length) (depth to top) <u>1/4"</u> <u>sch. 5, 5</u> (size) (material)			
(6) pump <u>2</u> <u>8</u> (HP) (yield gpm) <u>elec.</u> (type power)			
(7) electric log <u>no</u> (yes or no)			
(8) how well bottom plugged <u>flush point</u>			
DRILLERS REMARKS:			


5' 1/4 8 sch 55 well
2 1/2' 1/4 log. bent in well
pumper

JUL 3 - 1969

MISS. BD. OF WATER COMM.

If well telescopes please sketch and show depths.

GROUND LEVEL

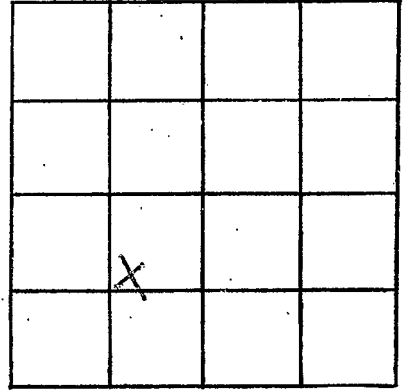

SECTION 33

Please indicate well location X.

ADDITIONAL INFORMATION

If more than one screen,
show locations of each on sketch.