

Wayne  
 O 109  
 5-27-69

MISSISSIPPI  
 BOARD OF WATER COMMISSIONERS  
 416 North State Street  
 Jackson, Mississippi 39201

CODED

WATER WELL DRILLERS LOG

Mar 27 1969 Probs Drilling & Log Wayne  
 date well completed firm name county well located

LANDOWNER: Jenny Mergal

description of formations encountered	from	to

Waynesboro Miss  
 (mailing address)

WELL LOCATION:

sec. 28 T 2 N R 6 E  
4 miles SE of Waynesboro  
 (distance) (direction) (nearest town)

red clay	0	8
Coarse sand	8	83
Blue Chalk	83	119
rock stratus.	119	160
Blue Chalk	160	166
red sand	166	198
more blue chalk	198	243
Uckabury long sand	243	272

WELL PURPOSE: home  
 (home, irrigation, municipal, industrial)

WELL COMPLETION DATA:

- (1) diameter (inches) 2"
- (2) total depth (feet) 272
- (3) static water level (feet) 53 below above top of ground.
- (4) casing steel 243  
 (material) (depth)  
2" if telescope see back.  
 (size)
- (5) screen none used  
 (length) (depth to top)  
 (size) (material)
- (6) pump 3/4 5  
 (HP) (yield gpm)  
elec.  
 (type power)
- (7) electric log no  
 (yes or no)  
 (organization running log)
- (8) how well bottom plugged open

6 3/4' 1/4" drag pipe  
3 1/2' break on end of  
2' case cement into rock


DRILLERS REMARKS: 106'  
case set to case off  
waiting loose sand

JUL 3 - 1969

MISS. BD. OF  
 WATER COMM.

If well telescopes please sketch and show depths.

GROUND LEVEL

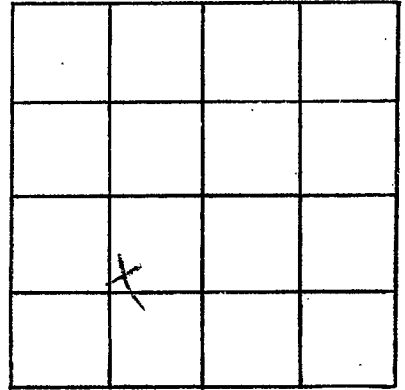

SECTION 28

Please indicate well location X.

ADDITIONAL INFORMATION

If more than one screen,  
show locations of each on sketch.