

Wayne
0111
5-1-69

MISSISSIPPI
BOARD OF WATER COMMISSIONERS
416 North State Street
Jackson, Mississippi 39201

CODED

WATER WELL DRILLERS LOG

May 1 1969 date well completed
Boyer Drilling & Log firm name
Madison county well located

LANDOWNER: Small Baptist
Parsonage
Waynesboro Miss
(mailing address)

WELL LOCATION:
sec. 6 T 20 N R 6 E
S W
1 miles NE of Waynesboro
(distance) (direction) (nearest town)

WELL PURPOSE: none
(home, irrigation, municipal, industrial)

WELL COMPLETION DATA:
(1) diameter (inches) 2"
(2) total depth (feet) 172
(3) static water level (feet) 114 (below/above top of ground)
(4) casing steel, 162,
(material) (depth)
2" if telescope see back.
(size)
(5) screen none used
(length) (depth to top)
(size) (material)
(6) pump 2 7
(HP) (yield gpm)
elec.
(type power)
(7) electric log no
(yes or no)
(organization running log)
(8) how well bottom plugged 24' 2" bentonite

description of formations encountered	from	to
<u>second water table</u>	<u>0</u>	<u>12</u>
<u>Chalk</u>	<u>12</u>	<u>19</u>
<u>Clay sand</u>	<u>19</u>	<u>25</u>
<u>Chalk</u>	<u>25</u>	<u>46</u>
<u>fine sand sand & chalk</u>	<u>46</u>	<u>53</u>
<u>blue chalk</u>	<u>53</u>	<u>104</u>
<u>rock shales</u>	<u>104</u>	<u>128</u>
<u>blue sand, sand</u>	<u>128</u>	<u>144</u>
<u>blue chalk</u>	<u>144</u>	<u>162</u>
<u>interstratified layers</u>		
<u>sand</u>	<u>162</u>	<u>172</u>


JUN 2 - 1969

MISS. BD. OF
WATER COMM.

DRILLERS REMARKS:
3' bentonite at end of casing lowered into well 124' 10" dry gauge

If well telescopes please sketch and show depths.

GROUND LEVEL

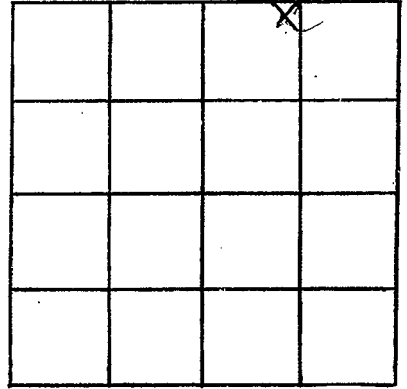

SECTION 6

Please indicate well location X.

ADDITIONAL INFORMATION

If more than one screen, show locations of each on sketch.