

Wayne
0112
5-12-69

MISSISSIPPI
BOARD OF WATER COMMISSIONERS
416 North State Street
Jackson, Mississippi 39201

CODED

WATER WELL DRILLERS LOG

May 12 1969 date well completed
Pete Drilling & Log firm name
Wayne county well located

LANDOWNER: J.E. Duffield
114 Magnolia Miss (mailing address)
WELL LOCATION:
sec. 18 T. 20 N. R. 6 E. (W)
1 miles S of Farmington (distance) (direction) (nearest town)

description of formations encountered	from	to
red clay	0	8
sand	8	13
blue chalk	18	32
rock stratum	32	39
blue chalk	39	59
rock stratum	59	72
blue chalk	72	79 1/2
fine grey sand	79 1/2	94
interbedded shale		
shale in sand		

WELL PURPOSE: home (home, irrigation, municipal, industrial)

WELL COMPLETION DATA:
(1) diameter (inches) 2"
(2) total depth (feet) 94'
(3) static water level (feet) 41' (below/above top of ground)
(4) casing 2" (material) 97' (depth)
2" if telescope see back. (size)
(5) screen 6' 88' (length) (depth to top)
1/2" 80 gr. S.S. (size) (material)
(6) pump 3/4 (HP) 7 (yield gpm)
elec. (type power)
(7) electric log none (yes or no)
(organization running log)
(8) how well bottom plugged


6' to 20 gr. S.S. well
2' 1/2" 80 gr. S.S. well
packer 50' 1/2" 80 gr. S.S.
JUN 2 1969

DRILLERS REMARKS:

MISS. DEP. OF WATER COMM.

If well telescopes please sketch and show depths.

GROUND LEVEL

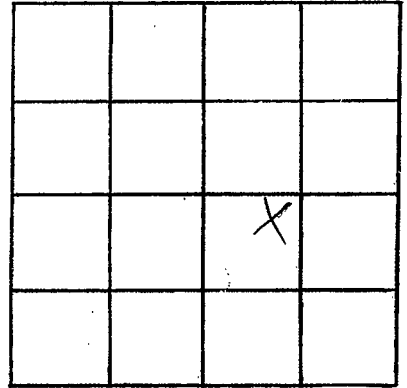

SECTION 12

Please indicate well location X.

ADDITIONAL INFORMATION

If more than one screen,
show locations of each on sketch.