

Wayne
0113
5-10-69

MISSISSIPPI
BOARD OF WATER COMMISSIONERS
416 North State Street
Jackson, Mississippi 39201

CODED

WATER WELL DRILLERS LOG

10/19/69 date well completed *Paul Dillingham* firm name *Wayne* county well located


LANDOWNER: <i>John M. ...</i>		description of formations encountered	from	to
(mailing address)				
WELL LOCATION: sec <u>19</u> T <u>20</u> N R <u>6</u> E S W		<i>Blue Chalk</i>	<i>0</i>	<i>12</i>
(distance) <u>1</u> miles (direction) <u>SE</u> of (nearest town) <u>Thornhill</u>		<i>blue chalk</i>	<i>13</i>	<i>20</i>
WELL PURPOSE: <u>...</u> (home, irrigation, municipal, industrial)		<i>blue chalk</i>	<i>20</i>	<i>25</i>
WELL COMPLETION DATA:		<i>blue chalk</i>	<i>35</i>	<i>44</i>
(1) diameter (inches) <u>2</u>		<i>blue chalk</i>	<i>44</i>	<i>63</i>
(2) total depth (feet) <u>75</u>		<i>blue chalk</i>	<i>63</i>	<i>80</i>
(3) static water level (feet) <u>115</u> ^{below} <u>20</u> above top of ground.		<i>blue chalk</i>	<i>80</i>	<i>95</i>
(4) casing <u>steel</u> <u>38</u> (material) (depth)		<i>blue chalk</i>	<i>83</i>	<i>95</i>
<u>2"</u> (size) if telescope see back.				
(5) screen <u>6'</u> <u>29</u> (length) (depth to top)				
<u>1 1/4"</u> <u>20 gpm S.S.</u> (size) (material)				
(6) pump <u>7 1/2</u> <u>7 1/2</u> (HP) (yield gpm)				
<u>elec</u> (type power)				
(7) electric log <u>no</u> (yes or no)				
(organization running log)				
(8) how well bottom plugged <u>...</u>				
DRILLERS REMARKS:				

JUN 2 1969

MISS. BD. OF WATER COMM.

If well telescopes please sketch and show depths.

GROUND LEVEL

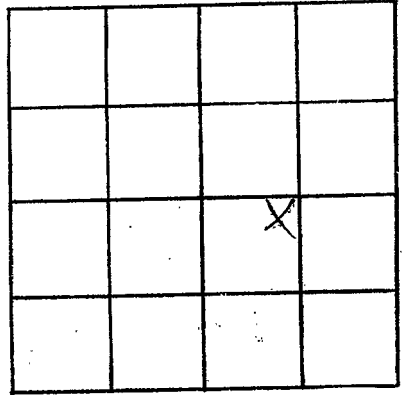

SECTION 18

Please indicate well location X.

ADDITIONAL INFORMATION

If more than one screen,
show locations of each on sketch.