

WAYNE
0114
4-21-69

MISSISSIPPI
BOARD OF WATER COMMISSIONERS
416 North State Street
Jackson, Mississippi 39201

CODED

WATER WELL DRILLERS LOG

4/21/69 19 Dozer Well Service Wayne
date well completed firm name county well located

LANDOWNER: Howard Holyfield
Rt #2

description of formations encountered	from	to
	Surface Soil	0
Clay	20	50
Sand	50	70

Waynesboro Miss
(mailing address)

WELL LOCATION:
sec. 19 T 8 N R 6 E
S W
6 miles S.E. of Waynesboro
(distance) (direction) (nearest town)

WELL PURPOSE: Home
(home, irrigation, municipal, industrial)

WELL COMPLETION DATA:


- (1) diameter (inches) 2
- (2) total depth (feet) 70
- (3) static water level (feet) 40 below top of ground.
- (4) casing Galv. 60 (material) (depth)
- (size) If telescope see back.
- (5) screen 5 ft 60 (length) (depth to top)
- 2 Brass (size) (material)
- (6) pump 1 6 (HP) (yield gpm)
- 110 S.P. (type power)
- (7) electric log No (yes or no)
- (organization running log)
- (8) how well bottom plugged B.W.V

DRILLERS REMARKS:

APR 28 1969
MISS. Bd. of WATER COMMISSIONERS

If well telescopes please sketch and show depths.

GROUND LEVEL

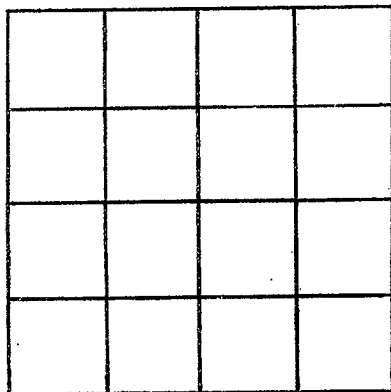

SECTION 19

Please indicate well location X.

ADDITIONAL INFORMATION

If more than one screen, show locations of each on sketch.