

MISSISSIPPI
BOARD OF WATER COMMISSIONERS
416 North State Street
Jackson, Mississippi 39201

CODED
CODED

WATER WELL DRILLERS LOG

WAYNE
0115
6-16-69

June 16 1969 P. H. Drilling, Inc. Wayne
date well completed firm name county well located


LANDOWNER:	description of formations encountered	from	to
description of formations encountered			
<p>Landowner: <u>Opie Clark</u> <u>Opie Clark</u></p>			
<p><u>Hampton Miss.</u> (mailing address)</p>	<p>0 6 chalk</p>	6	17
<p>WELL LOCATION: sec. <u>18</u> T <u>80</u> N R <u>6</u> E <u>1/4</u> miles S.E. of <u>Hampton</u> (distance) (direction) (nearest town)</p>	<p>17 17 brown ch. sh. 19 34 24 29 34 39 ch. ch. sh. 77 85 85 110 blue ch. sh. 110 119 119 160 160 192</p>		
<p>WELL PURPOSE: <u>water</u> (home, irrigation, municipal, industrial)</p>			
<p>WELL COMPLETION DATA:</p>			
<p>(1) diameter (inches) <u>2"</u></p>			
<p>(2) total depth (feet) <u>122'</u></p>			
<p>(3) static water level (feet) <u>26'</u> below above top of ground.</p>	<p>42' 1/4" change pipe</p>		
<p>(4) casing <u>gal</u> <u>160'</u> (material) (depth) <u>2"</u> if telescope see back. (size)</p>			
<p>(5) screen <u>1'</u> <u>1'</u> (length) (depth to top) (size) (material)</p>			
<p>(6) pump <u>3/4</u> <u>3</u> (HP) (yield gpm) <u>elec.</u> (type power)</p>			
<p>(7) electric log <u>no</u> (yes or no) (organization running log)</p>			
<p>(8) how well bottom plugged</p>			
<p>DRILLERS REMARKS:</p>			

AUG 15 1969

MISS. BLD. OR
MAILED

If well telescopes please sketch and show depths.

GROUND LEVEL

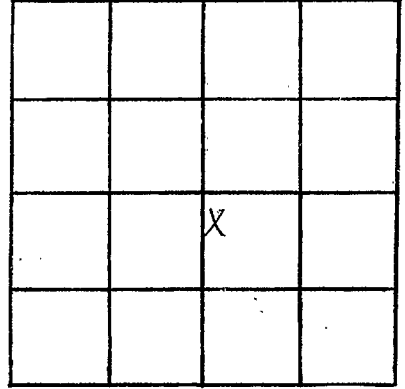

SECTION 18

Please indicate well location X.

ADDITIONAL INFORMATION

If more than one screen,
show locations of each on sketch.