

MISSISSIPPI BOARD OF WATER COMMISSIONERS 416 North State Street Jackson, Mississippi 39201

CODED

WATER WELL DRILLERS LOG

Wayne  
D 116  
8-69

Aug 15 1969 date well completed  
Bryce Drilling firm name  
Wayne county well located

LANDOWNER: Mrs. Aubrey  
Rounds

12 Magnolia Miss. (mailing address)

WELL LOCATION:  
sec. 5 T 8 N R 6 E  
S W  
2 miles east of Raymond (distance) (direction) (nearest town)

WELL PURPOSE: Home (home, irrigation, municipal, industrial)

WELL COMPLETION DATA:

- (1) diameter (inches) 2"
- (2) total depth (feet) 152
- (3) static water level (feet) 51 (below top of ground)
- (4) casing steel 124' (material) (depth)  
2" if telescope see back.
- (5) screen same as casing (length) (depth to top)  
(size) (material)
- (6) pump 1 (HP) 7 (yield gpm)  
elec (type power)
- (7) electric log no (yes or no)  
(organization running log)
- (8) how well bottom plugged


description of formations encountered	from	to
red clay	0	8
sand	8	25
blue chalk	25	30
sand	30	42
blue chalk	42	55
red clay	55	75
blue chalk	75	89
red sand	89	94
blue chalk	94	124
blue chalk	124	150
white chalk	150	152
63' 1/2" drop pipe		

SEP 24 1969  
MISSISSIPPI BOARD OF WATER COMMISSIONERS

DRILLERS REMARKS:

If well telescopes please sketch and show depths.

GROUND LEVEL

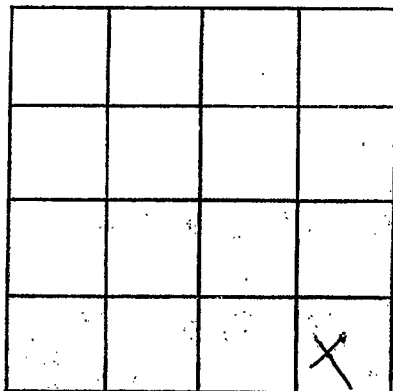

SECTION 5

Please indicate well location X.

ADDITIONAL INFORMATION

If more than one screen,  
show locations of each on sketch.