

Wayne  
0118  
9-16-69

MISSISSIPPI  
BOARD OF WATER COMMISSIONERS  
416 North State Street  
Jackson, Mississippi 39201

CODED


WATER WELL DRILLERS LOG

Sept 16 1969 Water Drilling & Log Wayne  
date well completed firm name county well located

LANDOWNER: <u>L. M. Holcomb</u>	description of formations encountered	from	to
<u>Rt 4 Waynesboro Miss.</u> (mailing address)	<u>red clay</u>	0	12
WELL LOCATION: sec <u>28</u> T <u>8</u> N R <u>6</u> E <u>3</u> miles <u>SE</u> of <u>Waynesboro</u> (distance) (direction) (nearest town)	<u>sand</u>	12	35
WELL PURPOSE: <u>home</u> (home, irrigation, municipal, industrial)	<u>chalk</u>	35	48
WELL COMPLETION DATA: (1) diameter (inches) <u>2"</u>	<u>red sand</u>	48	59
(2) total depth (feet) <u>92</u>	<u>med coarse white sand</u>	79	92
(3) static water level (feet) <u>42</u> <u>below</u> <u>above</u> top of ground.	<u>with some chalk</u>		
(4) casing <u>steel</u> <u>84'</u> (material) (depth)	<u>stopped on chalk</u>		
<u>2"</u> If telescope see back. (size)			
(5) screen <u>6'</u> <u>86'</u> (length) (depth to top)	<u>6' 60 ga S.S. with</u>		
(6) pump <u>1</u> <u>8</u> (HP) (yield gpm)	<u>2" 1/4" log pipe bent</u>		
(7) electric log <u>no</u> (yes or no)	<u>run with packer</u>		
(8) how well bottom plugged <u>flush sand</u>	<u>52' 1/4" log pipe</u>		
DRILLERS REMARKS:			
(organization running log)			
SFP 2/1 1969			
MISC. DD. OF			
WATER CO.			

If well telescopes please sketch and show depths.

GROUND LEVEL

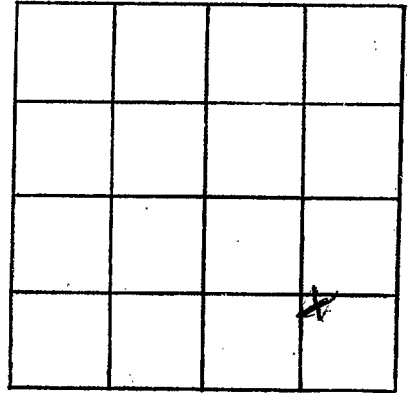

SECTION 28

Please indicate well location X.

ADDITIONAL INFORMATION

If more than one screen,  
show locations of each on sketch.