

Wayne  
 0 119  
 9-18-69

MISSISSIPPI  
 BOARD OF WATER COMMISSIONERS  
 416 North State Street  
 Jackson, Mississippi 39201

CODED


WATER WELL DRILLERS LOG

Sept 18, 1969 Porter Drilling & Equip Wayne  
 date well completed firm name county well located

LANDOWNER: <u>Julian James</u>	description of formations encountered	from	to
<u>At 2 Waynesboro Miss</u> (mailing address)	<u>red clay chalk sand strip on chalk</u>	<u>0 15 23</u>	<u>15 23 54</u>
WELL LOCATION: sec <u>4</u> T <u>80</u> N R <u>6</u> E S W <u>3</u> miles <u>east</u> of <u>Waynesboro</u> (distance) (direction) (nearest town)	<u>5' 1 1/4" slot S.S.</u>		
WELL PURPOSE: <u>home</u> (home, irrigation, municipal, industrial)	<u>screen removed in end of</u>		
WELL COMPLETION DATA:			
(1) diameter (inches) <u>2"</u>	<u>cas. 47' 1 1/4" charge pipe</u>		
(2) total depth (feet) <u>54</u>			
(3) static water level (feet) <u>45</u> <u>below</u> top of ground. <u>above</u>			
(4) casing <u>steel</u> <u>47'</u> (material) (depth)			
<u>2"</u> (size) if telescope see back.			
(5) screen <u>5'</u> <u>49</u> (length) (depth to top)			
<u>1 1/4"</u> <u>slot S.S.</u> (size) (material)			
(6) pump <u>3/4</u> <u>8</u> (HP) (yield gpm)			
<u>elec.</u> (type power)			
(7) electric log <u>no</u> (yes or no)			
(organization running log)			
(8) how well bottom plugged <u>plush cement</u>			
DRILLERS REMARKS: <u>Sept 24 1969</u>			

If well telescopes please sketch and show depths.

GROUND LEVEL

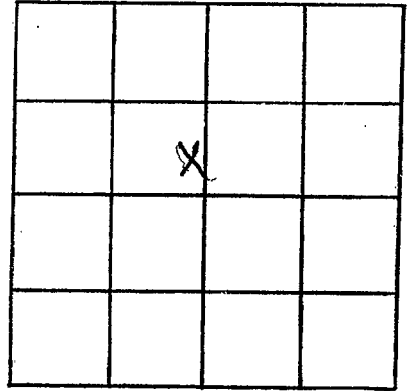

SECTION 4

Please indicate well location X.

ADDITIONAL INFORMATION

If more than one screen,  
show locations of each on sketch.