

MISSISSIPPI  
 BOARD OF WATER COMMISSIONERS  
 416 North State Street  
 Jackson, Mississippi 39201

CODED

WATER WELL DRILLERS LOG

WAYNE  
 0120  
 9-5-69

Sept 5 1969 - Bozen Well Service Wayne  
 date well completed firm name county well located

LANDOWNER: C. Hoover

Waynesboro, Miss  
RT # 2  
 (mailing address)

description of formations encountered

from to

<u>Sand</u>	<u>0</u>	<u>20</u>
<u>Gravel + shale</u>	<u>20</u>	<u>50</u>
<u>Sand + Gravel</u>	<u>50</u>	<u>80</u>

WELL LOCATION:

sec 6 T 8N R 6E  
3 miles N.E. of Waynesboro  
 (distance) (direction) (nearest town)

WELL PURPOSE: Home  
 (home, irrigation, municipal, industrial)

WELL COMPLETION DATA:

- (1) diameter (inches) 2 5/8
- (2) total depth (feet) 80
- (3) static water level (feet) 20 below above top of ground.
- (4) casing Gal. 70  
 (material) (depth)

(size) If telescope see back.

- (5) screen 5 70  
 (length) (depth to top)  
2 Steel  
 (size) (material)

- (6) pump 1 12  
 (HP) (yield gpm)

Elec. 220  
 (type power)

- (7) electric log NO  
 (yes or no)

(organization running log)


- (8) how well bottom plugged B.W

DRILLERS REMARKS:

SEP 11 1969  
 MISSISSIPPI BOARD OF WATER COMMISSIONERS

If well telescopes please sketch and show depths.

GROUND LEVEL

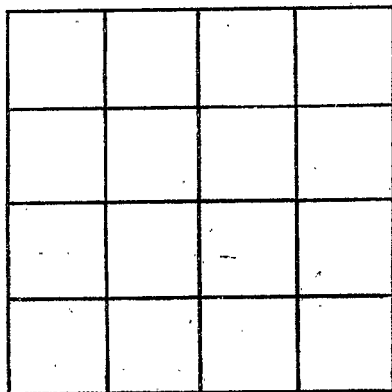

SECTION \_\_\_\_\_

Please indicate well location X.

ADDITIONAL INFORMATION

If more than one screen, show locations of each on sketch.