

Wayne
 122
 11-11-69

MISSISSIPPI
 BOARD OF WATER COMMISSIONERS
 416 North State Street
 Jackson, Mississippi 39201

CODED

WATER WELL DRILLERS LOG


Nov. 11 1969 Porter Drilling Co. Wayne
 date well completed firm name county well located

LANDOWNER:	description of formations encountered	from	to
Jones Cont. Co.	red clay	0	6
Waynesboro Miss. (mailing address)	Chalk	6	24
	Chalk & sand	24	26
	sand	26	32
WELL LOCATION:			
sec. 6 T. 80 N R. 6 E 1/4 miles N.E. of Waynesboro (distance) (direction) (nearest town)			
WELL PURPOSE: Home (home, irrigation, municipal, industrial)			
WELL COMPLETION DATA:			
(1) diameter (inches)	2"		
(2) total depth (feet)	32'		
(3) static water level (feet)	22' below top of ground		
(4) casing (material)	steel	(depth)	26'
	2" (size)		if telescope see back.
(5) screen (length)	5'	(depth to top)	27'
	1 1/2" (size)	(material)	60 gm. S.S.
(6) pump (HP)	1/2	(yield gpm)	7
	elec. (type power)		
(7) electric log	no	(yes or no)	
(organization running log)			
(8) how well bottom plugged	flush ground		
DRILLERS REMARKS:			

DEC - 1 1969
 Miss. Bd. of Water Comm.

If well telescopes please sketch and show depths.

GROUND LEVEL

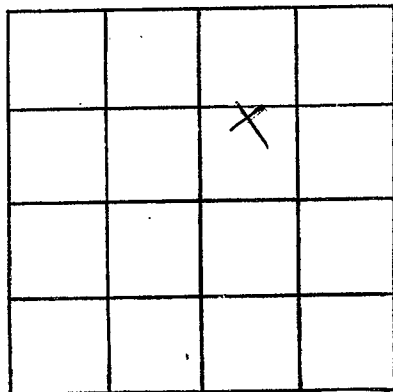

SECTION 6

Please indicate well location X.

ADDITIONAL INFORMATION

If more than one screen,
show locations of each on sketch.