

CODER

MISSISSIPPI  
BOARD OF WATER COMMISSIONERS  
416 North State Street  
Jackson, Mississippi 39201

Wayne  
125  
2-28-70

WATER WELL DRILLERS LOG

Feb 28 1970 Regier Well Service Wayne  
date well completed firm name county well located

LANDOWNER: Roy O'Leary  
RT # 4  
Waynesboro miss  
(mailing address)

| description of formations encountered | from                | to        |
|---------------------------------------|---------------------|-----------|
|                                       | <u>Surface sand</u> | <u>0</u>  |
| <u>Clay</u>                           | <u>10</u>           | <u>35</u> |
| <u>Sand</u>                           | <u>35</u>           | <u>58</u> |

WELL LOCATION:  
sec 20 T S R 6 E  
2 miles East Waynesboro  
(distance) (direction) (nearest town)

WELL PURPOSE:  
(home) irrigation, municipal, industrial

- WELL COMPLETION DATA:
- (1) diameter (inches) 2 inches
  - (2) total depth (feet) 58
  - (3) static water level (feet) 46 below top of ground
  - (4) casing Galv 48  
(material) (depth)
  - (size) If telescope see back.
  - (5) screen 10 48  
(length) (depth to top)
  - 2 in Steel  
(size) (material)
  - (6) pump 1 4 1/2  
(HP) (yield gpm)
  - 110  
(type power)
  - (7) electric log No  
(yes or no)

FILED

(organization running log)  
(8) how well bottom plugged B.W.V


MAR 17 1970

MISS. BD. OF  
WATER COMM.

DRILLERS REMARKS:

If well telescopes please sketch and show depths.

GROUND LEVEL

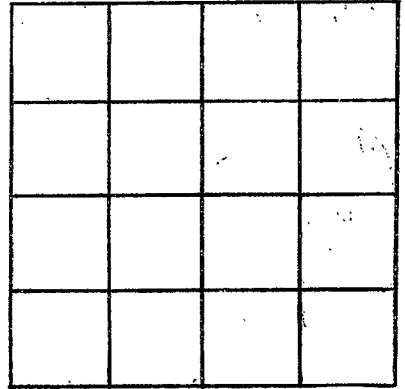

SECTION \_\_\_\_\_

Please indicate well location X.

ADDITIONAL INFORMATION

If more than one screen, show locations of each on sketch.