

CODED

MISSISSIPPI BOARD OF WATER COMMISSIONERS
416 North State Street
Jackson, Mississippi 39201

WATER WELL DRILLERS LOG

Wayne
Ø126
3-2-70

3/4 1970 Northwell Service Wayne
date well completed firm name county well located

LANDOWNER: J. L. 1999
Waynesboro Miss

| description of formations encountered | from | to |
|---------------------------------------|---------------------|------------|
| | <u>Surface soil</u> | <u>0</u> |
| <u>Clay</u> | <u>20</u> | <u>100</u> |
| <u>Sand</u> | <u>100</u> | <u>199</u> |

(mailing address)

WELL LOCATION:
sec 20 T 8 N R 6 E
3 miles S of Waynesboro
(distance) (direction) (nearest town)

WELL PURPOSE:
(home, irrigation, municipal, industrial)

WELL COMPLETION DATA:

- (1) diameter (inches) 2
- (2) total depth (feet) 199
- (3) static water level (feet) 60 below top of ground
- (4) casing Gal. 189
(material) (depth)
- (size) If telescope see back.
- (5) screen 10 199
(length) (depth to top)
2 inch 5 feet
(size) (material)
- (6) pump 1 10
(HP) (yield gpm)
210
(type power)
- (7) electric log No
(yes or no)

(organization running log)

(8) how well bottom plugged B.W.V.

DRILLERS REMARKS:


CODED

REC'D. MAR 17 1970

REC'D. SD. OF WATER COMM.

If well telescopes please sketch and show depths.

GROUND LEVEL

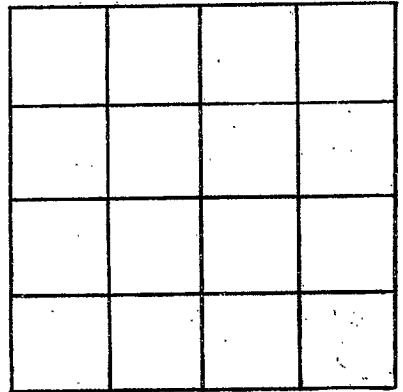

SECTION _____

Please indicate well location X.

ADDITIONAL INFORMATION

If more than one screen, show locations of each on sketch.