

CODED

MISSISSIPPI  
BOARD OF WATER COMMISSIONERS  
416 North State Street  
Jackson, Mississippi 39201

WATER WELL DRILLERS LOG

Wayne  
Ø 127  
3-9-70

3/9 1970 date well completed  
Rozier Well Service firm name  
Wayne county well located

LANDOWNER: James Anderson

description of formations encountered	from	to
	Sand	0
Clay	15	35
Gravel	35	48

RTF ✓  
James Anderson  
(mailing address)

WELL LOCATION:  
sec. 7 T. 8 N. R. 6 E.  
4 miles East of Magnolia.  
(distance) (direction) (nearest town)

WELL PURPOSE:  
(home, irrigation, municipal, industrial)

WELL COMPLETION DATA:

- (1) diameter (inches) 2 inches
- (2) total depth (feet) 48
- (3) static water level (feet) 40 below top of ground
- (4) casing Gal. 43 (material) (depth)
- (5) screen 5 48 (length) (depth to top)  
2 inch Steel (size) (material)
- (6) pump 3/4 3 1/2 (HP) (yield gpm)  
13/0 (type power)
- (7) electric log (yes or no)

(organization running log)

(8) how well bottom plugged B.W.V

DRILLERS REMARKS:


CODED

MAR 17 1970

MISS. BD. OF  
WATER COMM.

If well telescopes please sketch and show depths.

GROUND LEVEL

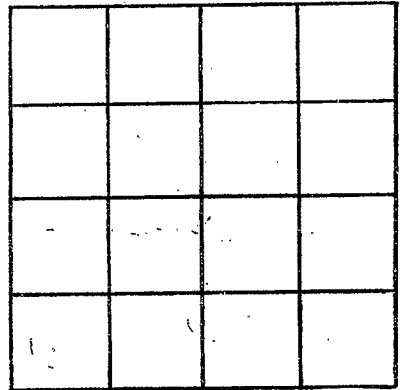

SECTION \_\_\_\_\_

Please indicate well location X.

ADDITIONAL INFORMATION

If more than one screen, show locations of each on sketch.