

Wayne
 129
 5-20-70

MISSISSIPPI
 BOARD OF WATER COMMISSIONERS
 416 North State Street
 Jackson, Mississippi 39201

WATER WELL DRILLERS LOG

May 20 1970 Porter Drilling & Pumping Wayne
 date well completed firm name county well located

LANDOWNER: Gardner & Jones
 Rt. 2
 Waynesboro Miss
 (mailing address) 033
 sec. 6 T. 80 N. R. 6 E.
 1 miles NE of Waynesboro
 (distance) (direction) (nearest town)

description of formations encountered	from	to
red clay to chalk	0	16
part of chalk	16	19
part of	19	28
stratum on chalk		

WELL PURPOSE: none
 (home, irrigation, municipal, industrial)

WELL COMPLETION DATA:

(1) diameter (inches) 2"
 (2) total depth (feet) 28'
 (3) static water level (feet) 11' (below above top of ground)
 (4) casing steel 22' (material) (depth)
 2" (size) if telescope see back.
 (5) screen 6' 22' (length) (depth to top)
 1 1/2" 60 ga. S.S. (size) (material)
 (6) pump 1/2 (HP) 10 (yield gpm)
 elec. (type power)
 (7) electric log no (yes or no)
 (organization running log)

6 1/4" 60 ga. S.S. with
 1 1/2" 1 1/2" bay pipe
 test in with packer
 1 1/2" 1 1/4" drop 2200
 1.11


MAY 28 1970

MISS. BD. OF
 WATER COMM.

DRILLERS REMARKS:

If well telescopes please sketch and show depths.

GROUND LEVEL

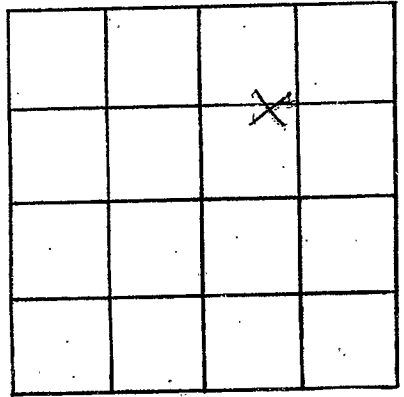

SECTION 6

Please indicate well location X.

ADDITIONAL INFORMATION

Lined area for additional information.

If more than one screen, show locations of each on sketch.