

WAYNE
 Ø 131
 12-12-70

MISSISSIPPI
 BOARD OF WATER COMMISSIONERS
 416 North State Street
 Jackson, Mississippi 39201

CODED

WATER WELL DRILLERS LOG

DEC. 13 1970 HOLLAND'S WELL SERV. WAYNE
 date well completed firm name county well located

LANDOWNER: JIM CALHOUN
ROUT 2
WAYNESBORO, MISS.
 (mailing address)

description of formations encountered	from	to
TOP SOIL	0	1
YELLOW CLAY	1	4
LIGHT RED CLAY + SAND	4	13
RED SAND	13	26
WHITE CHALK	26	35
CORSE WATER SAND	35	41

WELL LOCATION:
 sec. 9 T. 8 S. R. 6 E.
4 miles EAST of WAYNESBORO
 (distance) (direction) (nearest town)

WELL PURPOSE: HOME
 (home, irrigation, municipal, industrial)

WELL COMPLETION DATA:

(1) diameter (inches) 2"

(2) total depth (feet) 41'

(3) static water level (feet) 22' ^{below} above top of ground.

(4) casing PLASTIC, 36'
 (material) (depth)
2" if telescope see back.
 (size)

(5) screen 5', 36'
 (length) (depth to top)
2", PLASTIC
 (size) (material)

(6) pump 1/2, 3 1/2
 (HP) (yield gpm)

ELECT.
 (type power)

(7) electric log NO
 (yes or no)

(organization running log)

(8) how well bottom plugged B.W.V.


CODED

DRILLERS REMARKS:

JAN 5 - 1971
 MISS. Bd. OF
 WATER COM.

If well telescopes please sketch and show depths.

GROUND LEVEL

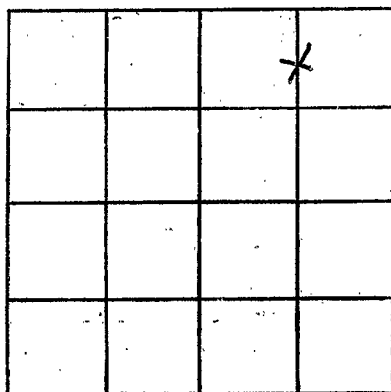

SECTION 9

Please indicate well location X.

ADDITIONAL INFORMATION

If more than one screen, show locations of each on sketch.