

WAYNE

133

9-10-70

MISSISSIPPI BOARD OF WATER COMMISSIONERS 416 North State Street Jackson, Mississippi 39201

CODED

WATER WELL DRILLERS LOG

Sept. 10 1970 Roots Drilling & Log Wayne date well completed firm name county well located

LANDOWNER: Thula Cooper Rt 2 Hargreaves Miss (mailing address)

Table with 3 columns: description of formations encountered, from, to. Rows include: Chalk (0-13), sand (13-22), blue chalk (22-41), sand strata (41-57), blue chalk (57-109), Natchezian limestone (109-135)

WELL LOCATION: sec 9 T 20 N R 6 E S W 3 miles east of Hargreaves (distance) (direction) (nearest town)

WELL PURPOSE: none (home, irrigation, municipal, industrial)

63' 1/2" drop pipe

- WELL COMPLETION DATA: (1) diameter (inches) 2" (2) total depth (feet) 135' (3) static water level (feet) 37 below top of ground (4) casing steel, 109' (material) (depth) 2" (size) if telescope see back. (5) screen none used (length) (depth to top) (size) (material) (6) pump 3/4 HP, 9 (yield gpm) elec. (type power) (7) electric log no (yes or no) (organization running log) (8) how well bottom plugged? open bottom case.


CODED

DRILLERS REMARKS:

1027 5 2070

If well telescopes please sketch and show depths.

GROUND LEVEL

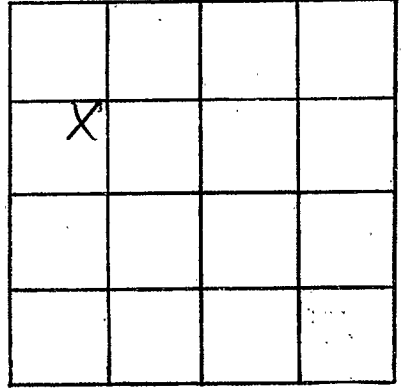

SECTION 9

Please indicate well location X.

ADDITIONAL INFORMATION

If more than one screen,  
show locations of each on sketch.