

WAYNE
 134
 9-19-70

MISSISSIPPI
 BOARD OF WATER COMMISSIONERS
 416 North State Street
 Jackson, Mississippi 39201

CODED


WATER WELL DRILLERS LOG

9/19 1970 CARRS WATER WELL SERV WAYNE
 date well completed firm name county well located

LANDOWNER:	description of formations encountered	from	to
KEN HERRING	Top soil	0	1
RT 2 WAYNESBORO MISS (mailing address)	Red SANDY CLAY	1	7
	Red SAND	7	23
	Med yellowish SAND	23	45
	GRAVEL w/ white CLAY	45	51
	PINK & white CLAY	51	53
	Fine FINE SAND	53	63
	PINK, white, & yellow CLAY w/ BROWN ROCK	63	68
	Med white to yellow SD	68	77
	CARRS yellowish SD	77	84
	yellow CLAY w/ BROWN ROCK	84	90
WELL LOCATION: sec 20 T 8 N R 6 E 4 miles N.E. of WAYNES (distance) (direction) of WAYNES (nearest town)	<p>CODED</p>		
WELL PURPOSE: HOME (home, irrigation, municipal, industrial)			
WELL COMPLETION DATA:			
(1) diameter (inches) 4" x 2"			
(2) total depth (feet) 90'			
(3) static water level (feet) 53' below top of ground.			
(4) casing GALV 72' (material) (depth)			
(size) if telescope see back.			
(5) screen 4' 72' (length) (depth to top)			
2" PLASTIC (8510T) (size) (material)			
(6) pump 1 (HP) 7 (yield gpm)			
ELECT (type power)			
(7) electric log NO (yes or no)			
(organization running log)			
(8) how well bottom plugged 2" B.W.V.			
DRILLERS REMARKS:	OCT 1 1970		
	MISS. BD. OF WATER COMM.		

If well telescopes please sketch and show depths.

GROUND LEVEL

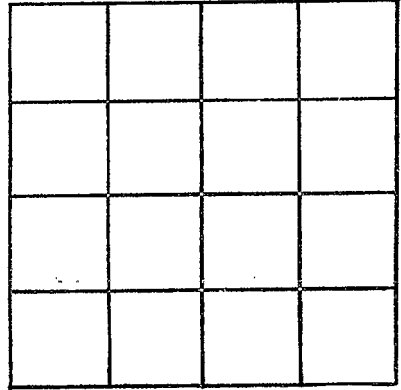

SECTION _____

Please indicate well location X.

ADDITIONAL INFORMATION

If more than one screen,
show locations of each on sketch.