

MISSISSIPPI  
BOARD OF WATER COMMISSIONERS  
416 North State Street  
Jackson, Mississippi 39201

**CODED**

WATER WELL DRILLERS LOG

Wayne  
Ø 135  
7-10-70

July 10 1970 Porter Drilling & Log Wayne  
date well completed firm name county well located

LANDOWNER: Wete Mc Eal  
Box 2 Waynesboro Miss  
(mailing address)

WELL LOCATION:  
sec. 9 T. 80 N. R. 6  
3 miles east of Waynesboro  
(distance) (direction) (nearest town)

WELL PURPOSE: none  
(home, irrigation, municipal, industrial)

- WELL COMPLETION DATA:
- (1) diameter (inches) 2"
  - (2) total depth (feet) 210'
  - (3) static water level (feet) 99' below top of ground.
  - (4) casing steel 183'  
(material) (depth)  
2" if telescope see back.  
(size)
  - (5) screen: none used  
(length) (depth to top)  
(size) (material)
  - (6) pump 2 7 1/2  
(HP) (yield gpm)  
elec.  
(type power)
  - (7) electric log no  
(yes or no)
  - (organization running log)
  - (8) how well bottom plugged open


description of formations encountered	from	to
red clay	0	9
red chaptk	9	15
sand	15	25
chalk	25	37
sand & chalk	37	42
chalky	42	50
sand	50	55
blue chalk	55	62
red sand	62	73
blue chalk	73	85
grey sand & chaptk	85	97
blue chalk	97	114
red strata	114	122
blue chalk	122	182
Duckburg honeycom	182	210
126' 1/4" large gauge		
<b>CODED</b>		

DRILLERS REMARKS:

AUG 11 1970

If well telescopes please sketch and show depths.

GROUND LEVEL

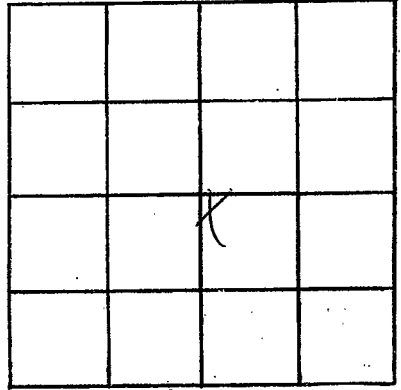

SECTION 9

Please indicate well location X.

ADDITIONAL INFORMATION

If more than one screen,  
show locations of each on sketch.