

MISSISSIPPI  
BOARD OF WATER COMMISSIONERS  
416 North State Street  
Jackson, Mississippi 39201

**CODED**

WATER WELL DRILLERS LOG

Way NE  
Ø136  
8-2-70


Aug 2 1970 Porter Drilling Co Wayne  
date well completed firm name county well located

LANDOWNER: <u>M.C. Manning</u>	description of formations encountered	from	to
Pt 6 Laurel Miss (mailing address)	Clay Chalk	0	3
WELL LOCATION: sec. <u>18</u> T <u>8</u> N R <u>6</u> <u>1</u> miles <u>SE</u> of <u>Waynesboro</u> (distance) (direction) (nearest town)	sand & pea gravel blue Chalk rock strata blue Chalk rock strata	14	35
WELL PURPOSE: <u>Home</u> (home, irrigation, municipal, industrial)	blue Chalk rock strata fine green sand stand build still in case	35	45
WELL COMPLETION DATA:			
(1) diameter (inches) <u>2"</u>	6' 1 1/2" 80 ga S.S.		
(2) total depth (feet) <u>111'</u>	with 2' 1 1/4" log part		
(3) static water level (feet) <u>61</u> (below/above top of ground)	in well packer		
(4) casing <u>steel</u> <u>105'</u> (material) (depth) <u>2"</u> if telescope see back. (size)	73' 1 1/4" large pipe		
(5) screen <u>6'</u> <u>105'</u> (length) (depth to top) <u>1 1/4"</u> <u>80 ga S.S.</u> (size) (material)			
(6) pump <u>1</u> <u>10</u> (HP) (yield gpm) <u>elec.</u> (type power)			
(7) electric log <u>no</u> (yes or no)			
(organization running log)			
(8) how well bottom plugged <u>flush point</u>			
DRILLERS REMARKS:	AUG 13 1970		

**CODED**

If well telescopes please sketch and show depths.

GROUND LEVEL

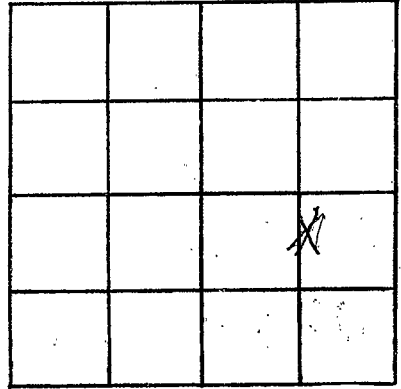

SECTION 18

Please indicate well location X.

ADDITIONAL INFORMATION

If more than one screen,  
show locations of each on sketch.