

WAYNE

Φ137.

7-14-70

MISSISSIPPI BOARD OF WATER COMMISSIONERS
416 North State Street
Jackson, Mississippi 39201

CODED

WATER WELL DRILLERS LOG

July 14 1970

Raymond Well Service

Wayne

date well completed

firm name

county well located

LANDOWNER: John Williams

description of formations encountered

from

to

Waynesboro,

Sand

0 50

(mailing address)

Shale

50 160

Hoey Comp Rock

160 220

WELL LOCATION:

sec. 17 T. 8 N. R. 6 E.

SW

2 miles N of Waynesboro
(distance) (direction) (nearest town)

WELL PURPOSE: Home
(home, irrigation, municipal, industrial)

WELL COMPLETION DATA:

- (1) diameter (inches) 2
- (2) total depth (feet) 220
- (3) static water level (feet) 80 below above top of ground.

(4) casing Gal. 147
(material) (depth)

(size) If telescope see back.

(5) screen Open end
(length) (depth to top)

(size) (material)

(6) pump 1 5
(HP) (yield gpm)

Elec.
(type power)

(7) electric log No
(yes or no)

(organization running log)

(8) how well bottom plugged B.W.V

DRILLERS REMARKS:


CODED

OCT 21 1970

MISS. BD. OF WATER COMMISSIONERS

If well telescopes please sketch and show depths.

GROUND LEVEL

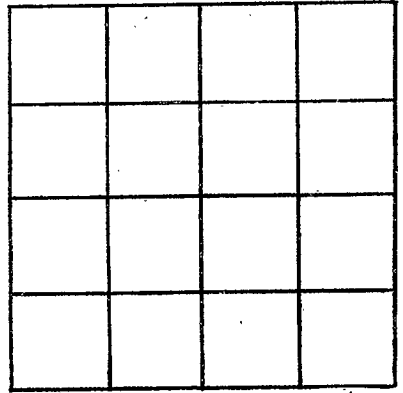

SECTION _____

Please indicate well location X.

ADDITIONAL INFORMATION

If more than one screen, show locations of each on sketch.