

WAYNE
 0138
 1-22-71

MISSISSIPPI
 BOARD OF WATER COMMISSIONERS
 416 North State Street
 Jackson, Mississippi 39201

CODED

WATER WELL DRILLERS LOG

Jan 22 1971 date well completed
 Porter Drilling, Inc. firm name
 Wayne county well located

LANDOWNER: Gene Graham
212 Haynesboro Miss
 (mailing address)

WELL LOCATION:
 sec. 1 T. 80 N. R. 6 E.
6 miles south of Waynesboro
 (distance) (direction) (nearest town)

WELL PURPOSE: home
 (home, irrigation, municipal, industrial)

- WELL COMPLETION DATA:
- (1) diameter (inches) 2"
 - (2) total depth (feet) 203'
 - (3) static water level (feet) 135' below top of ground.
 - (4) casing steel 177'
 (material) (depth)
2" if telescope see back.
 (size)
 - (5) screen none used
 (length) (depth to top)
 (size) (material)
 - (6) pump 1/2 5 1/2
 (HP) (yield gpm)
elec.
 (type power)
 - (7) electric log no
 (yes or no)
 - (organization running log)
 - (8) how well bottom plugged open

description of formations encountered	from	to
rest clay	0	20
rest sand	20	47
chalk & sand	47	57
lime sand	57	70
blue chalk	70	104
rock strata	104	126
blue chalk	126	176
Uchaburg rock	176	203

CODED

147' 1 1/2" drop pipe
 V V V


FEB 2 1971

DRILLERS REMARKS:

Misc. OF WATER

If well telescopes please sketch and show depths.

GROUND LEVEL

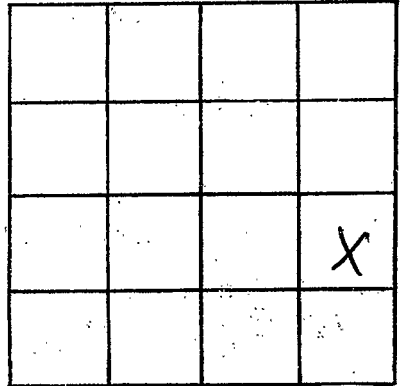

SECTION 1

Please indicate well location X.

ADDITIONAL INFORMATION

If more than one screen,
show locations of each on sketch.