

MISSISSIPPI
BOARD OF WATER COMMISSIONERS
416 North State Street
Jackson, Mississippi 39201

CODED

WATER WELL DRILLERS LOG

WAYNE
Ø 140
3-10-71

March 10 1971 W. D. D. Drilling Co. Wayne
date well completed firm name county well located

LANDOWNER: Henry Jordan
Ø Ø
Ø. W. Wagoner, Miss.
(mailing address)

description of formations encountered	from	to
red clay	0	8
sand to a depth	8	23
blue chalk	23	67
to sand streaks		
from clay	67	71
shout in chalk		

WELL LOCATION:
sec. 8 T. 8 N. R. 6 E.
S. W
2 miles east of Waynesboro
(distance) (direction) (nearest town)

WELL PURPOSE: irrigation
(home, irrigation, municipal, industrial)

WELL COMPLETION DATA:
(1) diameter (inches) 2"
(2) total depth (feet) 71'
(3) static water level (feet) 33' below top of ground.
(4) casing steel 67'
(material) (depth)
2" if telescope see back.
(size)
(5) screen 4' 67'
(length) (depth to top)
1/4" 8000 S.S.
(size) (material)
(6) pump 3/4 12
(HP) (yield gpm)
elec.
(type power)
(7) electric log no
(yes or no)
(organization running log)

4' 8000 S.S. that is
best producer
4' 2' 1/2' change pipe

CODED


APR - 8 1971

MISS. DE. OF
WATER COM.

(8) how well bottom plugged
flush
DRILLERS REMARKS:

If well telescopes please sketch and show depths.

GROUND LEVEL

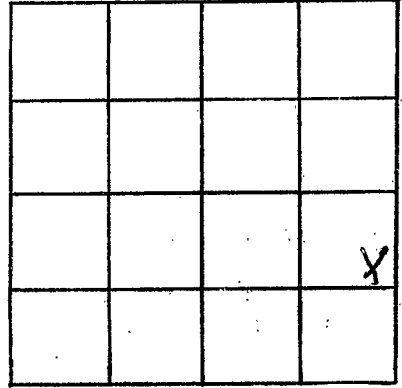

SECTION 8

Please indicate well location X.

ADDITIONAL INFORMATION

If more than one screen, show locations of each on sketch.