

CODED

WAYNE

Ø-141

7-8-71

MISSISSIPPI
BOARD OF WATER COMMISSIONERS
416 North State Street
Jackson, Mississippi 39201

CODED

WATER WELL DRILLERS LOG

July 8 1971 Drumwell Service Wayne
date well completed firm name county well located

LANDOWNER L.C. Gray

description of formations encountered

from to

Rt # 2

Waynesboro, Miss
(mailing address)

Clay

0 25

shale

11 40

WELL LOCATION:

sec. 16 T 80 N R 6 E
3 miles E of Waynesboro
(distance) (direction) (nearest town)

soft sand

40 50

WELL PURPOSE: Home
(home, irrigation, municipal, industrial)

WELL COMPLETION DATA:

- (1) diameter (inches) 2
- (2) total depth (feet) 50
- (3) static water level (feet) 30 below above top of ground.
- (4) casing Gal. 45
(material) (depth)
- (size) if telescope see back.
- (5) screen 5 45
(length) (depth to top)
- 2 Steel
(size) (material)
- (6) pump 1 10
(HP) (yield gpm)
- 1
(type power)
- (7) electric log No
(yes or no)

CODED

(organization running log)

(8) how well bottom plugged B.W.


AUG 23 1971

MISS. BD. OF
WATER COMM.

DRILLERS REMARKS:

If well telescopes please sketch and show depths.

GROUND LEVEL

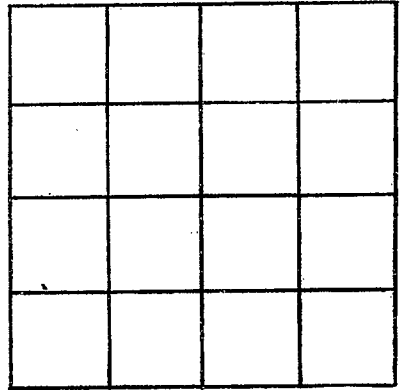

SECTION _____

Please indicate well location X.

ADDITIONAL INFORMATION

If more than one screen, show locations of each on sketch.