

CODED

WAYNE
 O-142
 7-13-71

MISSISSIPPI
 BOARD OF WATER COMMISSIONERS
 416 North State Street
 Jackson, Mississippi 39201

CODED

WATER WELL DRILLERS LOG

July 13, 1971 date well completed
 Registerwell Service Wayne firm name
 Wayne county well located

LANDOWNER: Eugene Bomer
 RT.

description of formations encountered	from	to
	Clay	0
Shale	10	40
Sand	40	60

Waynesboro, Miss
 (mailing address)

WELL LOCATION:
 sec 20 T 8 N R 6 E
 S W
 5 miles S of Waynesboro
 (distance) (direction) (nearest town)

WELL PURPOSE: Home
 (home, irrigation, municipal, industrial)

WELL COMPLETION DATA:

- (1) diameter (inches) 2
- (2) total depth (feet) 60
- (3) static water level (feet) 30 below above top of ground
- (4) casing Gal 5'5"
 (material) (depth)
- (5) screen 5'5"
 (length) (depth to top)
2 Steel
 (size) (material)
- (6) pump 1 20
 (HP) (yield gpm)
Elec.
 (type power)
- (7) electric log No.
 (yes or no)

CODED

(organization running log)

(8) how well bottom plugged B.W.


DRILLERS REMARKS:

AUG 20 1971

MISS. BD. OF
 WATER COM.

If well telescopes please sketch and show depths.

GROUND LEVEL

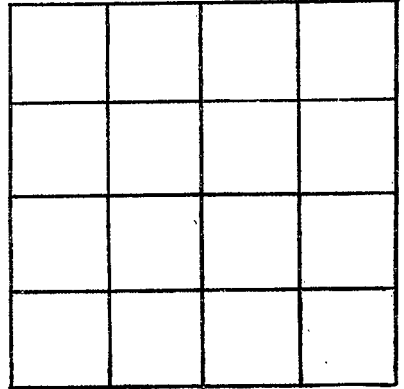

SECTION _____

Please indicate well location X.

ADDITIONAL INFORMATION

If more than one screen, show locations of each on sketch.