

Wayne
 0150
 12-10-71

MISSISSIPPI
 BOARD OF WATER COMMISSIONERS DEC 28 1971
 416 North State Street
 Jackson, Mississippi 39201

WATER WELL DRILLERS LOG

CODED

Dec 10 1971 date well completed
 Porter Drilling & Supply firm name
 Wayne county well located

LANDOWNER: Mrs Horace Britton

22 Waverlyboro Miss (mailing address)

WELL LOCATION:
 sec 5 T 80 N R 6 S
 2 miles east of Waverlyboro (distance) (direction) (nearest town)

WELL PURPOSE: Home (home, irrigation, municipal, industrial)

WELL COMPLETION DATA:

- (1) diameter (inches) 2"
- (2) total depth (feet) 184
- (3) static water level (feet) 92 below top of ground
- (4) casing steel 157 (material) (depth)
 2" (size) if telescope see back.
- (5) screen none used (length) (depth to top)
 (size) (material)
- (6) pump 1 5 1/2 (HP) (yield gpm)
 elec (type power)
- (7) electric log no (yes or no)
 (organization running log)
- (8) how well bottom plugged open

description of formations encountered	from	to
red clay	0	15
sand of a	15	45
blue chalk	45	70
small streaks	70	80
blue chalk	80	87
rock structure	87	109
blue chalk	109	157
Weathering rocks	157	184


105' 1 1/2" drop pipe

CODED

DRILLERS REMARKS:

If well telescopes please sketch and show depths.

GROUND LEVEL

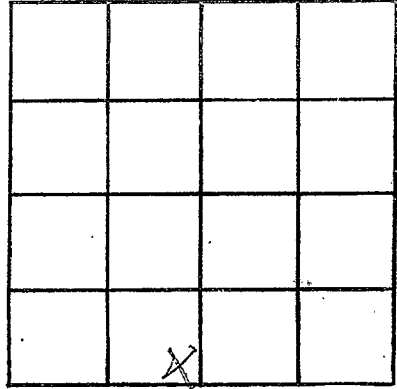

SECTION 5

Please indicate well location X.

ADDITIONAL INFORMATION

If more than one screen,
show locations of each on sketch.