

CODED

MISSISSIPPI
BOARD OF WATER COMMISSIONERS

416 North State Street

Jackson, Mississippi 39201 FEB 22 1972

WATER WELL DRILLERS LOG

Clanton + McIlwain

MISC. DR. OF

WAYNE
Ø 152
2-2-72

2-2
date well completed

1972 Water Well Serv.
firm name

Wayne
county well located

LANDOWNER:
Randolph McIlwain
Rt 2 Waynesboro, Miss.
(mailing address)

description of formations encountered	from	to
	red clay	0
sandy clay	8	20
sand	20	37

WELL LOCATION:
sec. 2 T. 8 N. R. 6 W
6 miles E of W'boro
(distance) (direction) (nearest town)

WELL PURPOSE: HOME
(home, irrigation, municipal, industrial)


- WELL COMPLETION DATA:
- (1) diameter (inches) 2"
 - (2) total depth (feet) 37
 - (3) static water level (feet) 24 below top of ground.
 - (4) casing 2" PVC, 32'
(material) (depth)
 - 2
(size) If telescope see back.
 - (5) screen 5', 32'
(length) (depth to top)
 - 2 PVC
(size) (material)
 - (6) pump 1/2 HP, 3
(HP) (yield gpm)
 - 110 AC
(type power)
 - (7) electric log no
(yes or no)
 - (organization running log)
 - (8) how well bottom plugged

CODED

DRILLERS REMARKS:

If well telescopes please sketch and show depths.

GROUND LEVEL

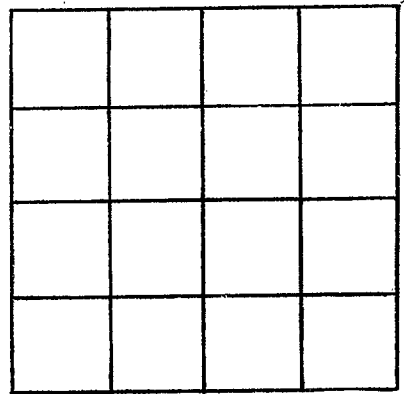

SECTION _____

Please indicate well location X.

ADDITIONAL INFORMATION

If more than one screen, show locations of each on sketch.