

MISSISSIPPI
BOARD OF WATER COMMISSIONERS
416 North State Street
Jackson, Mississippi 39201

CODED

Wayne
Ø 154
4-19-72

WATER WELL DRILLERS LOG
CLANTON + MRS. ILWAN
WATER WELL SERVICE

WAYNE

date well completed 19 Apr 19, 1972 firm name _____ county well located _____

LANDOWNER:
Community Southern Meth Church
Rt 2 Waynesboro, Miss.
(mailing address)

description of formations encountered	from	to
	<u>Red Clay + rock</u>	<u>0</u>
<u>Chalk</u>	<u>17</u>	<u>23</u>
<u>red sand</u>	<u>23</u>	<u>40</u>
<u>Water sand</u>	<u>40</u>	<u>50</u>

WELL LOCATION:
sec. 1 T. 8 (N) R. 6 (W)
7 miles (distance) E. (direction) of W BORO (nearest town)

WELL PURPOSE: CHURCH
(home, irrigation, municipal, industrial)

- WELL COMPLETION DATA:
- (1) diameter (inches) 2"
 - (2) total depth (feet) 50'
 - (3) static water level (feet) 33' below above top of ground.
 - (4) casing PVC 45' (material) (depth)
2" (size) If telescope see back.
 - (5) screen 2" x 5" 45' (length) (depth to top)
2" (size) PVC .006 SLOT (material)
 - (6) pump 3/4 6 (HP) (yield-gpm)
220 V. AC. (type power)
 - (7) electric log no (yes or no)
 - (organization running log) _____
 - (8) how well bottom plugged Backwash VALVE.

CODED


MAY 10 1972

DRILLERS REMARKS: GRAVEL PACKED AROUND SCREEN.

MIS. D. WATER C.

If well telescopes please sketch and show depths.

GROUND LEVEL

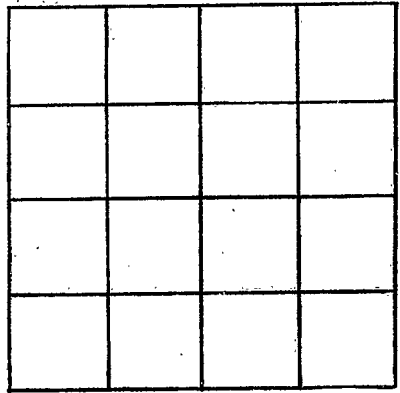

SECTION _____

Please indicate well location X.

ADDITIONAL INFORMATION

If more than one screen,
show locations of each on sketch.