

WAYNE
0157
4-28-72

MISSISSIPPI
BOARD OF WATER COMMISSIONERS
 416 North State Street
 Jackson, Mississippi 39201

WATER WELL DRILLERS LOG


April 28 1972 *Auto Drilling & Pump* *Wayne*
 date well completed firm name county well located

LANDOWNER: <i>L. Cortez Williams</i> <i>of Miss.</i>		description of formations encountered	from	to
<i>Waynesboro Miss</i> (mailing address)				
WELL LOCATION:		<i>Clay</i>	<i>0</i>	<i>10</i>
sec. <i>18</i> T <i>2</i> N R <i>6</i> E	<i>Waynesboro</i>	<i>sand</i>	<i>10</i>	<i>24</i>
<i>1/2</i> miles S (distance)	(direction)	<i>blue chalk</i>	<i>24</i>	<i>33</i>
(nearest town)		<i>rock</i>	<i>33</i>	<i>34</i>
WELL PURPOSE: <i>Industrial</i> (home, irrigation, municipal, industrial)		<i>blue chalk</i>	<i>34</i>	<i>58</i>
WELL COMPLETION DATA:		<i>rock strata</i>	<i>58</i>	<i>74</i>
(1) diameter (inches) <i>4"</i>		<i>mostly chalk some sand</i>	<i>74</i>	<i>97</i>
(2) total depth (feet) <i>126'</i>		<i>sand</i>	<i>97</i>	<i>126</i>
(3) static water level (feet) <i>33</i> (below top of ground)		<i>at top of chalk</i>		
(4) casing <i>steel</i> <i>105'</i> (material) (depth)				
<i>4"</i> (size) If telescope see back.				
(5) screen <i>10'</i> <i>115'</i> (length) (depth to top)				
<i>2 1/2"</i> (size) <i>S.S.</i> (material)				
(6) pump <i>1</i> <i>30</i> (HP) (yield gpm)				
<i>elec.</i> (type power)				
(7) electric log <i>no</i> (yes or no)				
(organization running log)				
(8) how well bottom plugged <i>back wash valve</i>				
DRILLERS REMARKS:				

MAY 27 1972
 MISS. BW. (2)
 JACKSON, MISS.

If well telescopes please sketch and show depths.

GROUND LEVEL

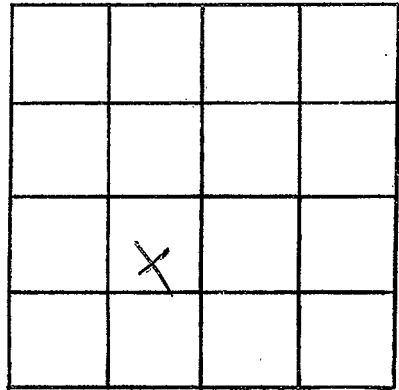

SECTION 18

Please indicate well location X.

ADDITIONAL INFORMATION

If more than one screen,
show locations of each on sketch.