

Wayne
 0159
 9-14-72

MISSISSIPPI
 BOARD OF WATER COMMISSIONERS
 416 North State Street
 Jackson, Mississippi 39201

CODED

WATER WELL DRILLERS LOG

CANTON & MRS. J. L. WAIN

SEPT 4

1972

WATER WELL SER

WAYNE

date well completed

firm name

county well located

LANDOWNER:	description of formations encountered	from	to
EARNEST JAMES			
Rt 4 Waynesboro, Miss. (mailing address)	Sand	12	17
WELL LOCATION:	Clay	17	25
sec. 5 T. 8 N R. 6 E W	Sand	25	28
2 miles E of W'BORO (distance) (direction) (nearest town)	Clay	28	46
WELL PURPOSE: HOME (home, irrigation, municipal, industrial)	Sand + Clay	46	60
WELL COMPLETION DATA:	Sand	60	75
(1) diameter (inches) 2"	Clay	75	—
(2) total depth (feet) 75			
(3) static water level (feet) 32' below top of ground.			
(4) casing PVC 70' (material) (depth)			
2" If telescope see back. (size)			
(5) screen 5' 70' (length) (depth to top)			
2" PVC .008 (size) (material)			
(6) pump 1 6 (HP) (yield gpm)			
110 AC (type power)			
(7) electric log NO (yes or no)			
(organization running log)			
(8) how well bottom plugged			
DRILLERS REMARKS:			


CODED

SEP 19 1972

MISS. BD. OF
 WATER COMMISSIONERS

If well telescopes please sketch and show depths.

GROUND LEVEL

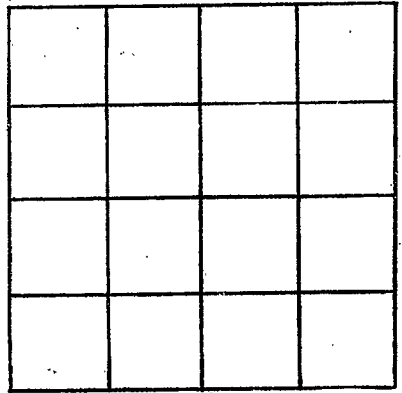

SECTION _____

Please indicate well location X.

ADDITIONAL INFORMATION

Multiple horizontal lines for writing additional information.

If more than one screen, show locations of each on sketch.