

MISSISSIPPI
BOARD OF WATER COMMISSIONERS
416 North State Street
Jackson, Mississippi 39201

WATER WELL DRILLERS LOG

CODED

CLAYTON & McILWAIN
1972 WATER WELL SER.

Wayne
0160
9-18-72

Aug 18, 1972
date well completed

1972
firm name

WAYNE
county/well located

LANDOWNER:	description of formations encountered	from	to
Cecil Williams			
RT 2 WAYNESBORO, MISS (mailing address)	Red sand	11	13
	Clay	13	25
WELL LOCATION:	fine sand	25	28
	Clay	28	33
sec <u>5</u> T <u>8</u> N R <u>6</u> E	sand	33	48
<u>2</u> miles <u>E</u> of WAYNESBORO (distance) (direction) (nearest town)	Clay	48	50
WELL PURPOSE: <u>HOME</u> (home, irrigation, municipal, industrial)	sand	50	75
	Clay	75	77
WELL COMPLETION DATA:	sand	77	98
(1) diameter (inches) <u>2"</u>			
(2) total depth (feet) <u>99'</u>			
(3) static water level (feet) <u>64</u> below above top of ground.			
(4) casing <u>PVC</u> , <u>93'</u> (material) (depth)			
<u>2"</u> (size) if telescope see back.			
(5) screen <u>5'</u> , <u>93'</u> (length) (depth to top)			
<u>2"</u> , <u>PVC 008</u> (size) (material)			
(6) pump <u>1</u> , <u>6</u> (HP) (yield gpm)			
<u>220 AC</u> (type power)			
(7) electric log <u>NO</u> (yes or no)			
(organization running log)			
(8) how well bottom plugged			
DRILLERS REMARKS:			


CODED

SEP 19 1972

MISS. BD. OF
WATER COMM

If well telescopes please sketch and show depths.

GROUND LEVEL

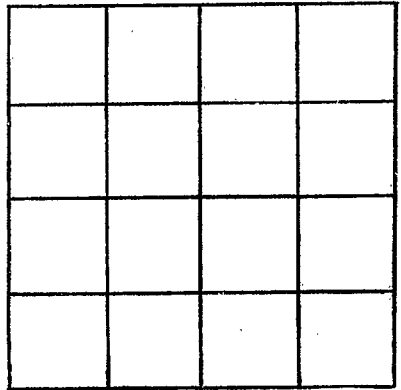

SECTION _____

Please indicate well location X.

ADDITIONAL INFORMATION

If more than one screen, show locations of each on sketch.