

Wayne
 0161
 7-28-72

MISSISSIPPI
 BOARD OF WATER COMMISSIONERS
 416 North State Street
 Jackson, Mississippi 39201

WATER WELL DRILLERS LOG

CODED

July 28 1972 date well completed
 Porter Drilling & Pump firm name
 county well located

LANDOWNER:	description of formations encountered	from	to
Doris Gordon	clay	0	15
Box 47 Wagnon, Miss (mailing address)	sand & gravel	15	85
WELL LOCATION: sec 28 T 20 N R 6 E S 3 W	blue chalk	85	120
3 miles SE Wagnon (distance) (direction) of (nearest town)	rock strata	120	164
WELL PURPOSE: home (home, irrigation, municipal, industrial)	crk chalk	164	175
WELL COMPLETION DATA:	sand, rock, chalk	175	204
(1) diameter (inches) 2"	red sand	204	246
(2) total depth (feet) 275'	blue chalk	246	275
(3) static water level (feet) 56' below top of ground	Urbana rocks		
(4) casing steel 246' (material) (depth)			
2" if telescope see back. (size)			
(5) screen none used (length) (depth to top)			
(size) (material)			
(6) pump 1 HP 7 1/2 (HP) (yield gpm)			
elec. (type power)			
(7) electric log no (yes or no)			
(organization running log)			
(8) how well bottom plugged open			
DRILLERS REMARKS: 106' 4" casing			


CODED

SEP 5 1972

Miss. Bd. of
 WATER COMMISSIONERS

If well telescopes please sketch and show depths.

GROUND LEVEL

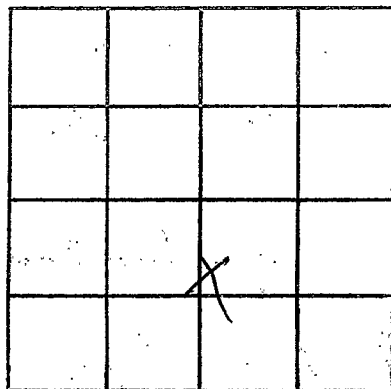

SECTION 28

Please indicate well location X.

ADDITIONAL INFORMATION

If more than one screen,
show locations of each on sketch.