

**MISSISSIPPI  
BOARD OF WATER COMMISSIONERS  
416 North State Street  
Jackson, Mississippi 39201**

**WAYNE**  
 163  
 10-10-72

**WATER WELL DRILLERS LOG**

**CODING**

date well completed Oct 10 1972 firm name Porter Drilling & Supply county well located Cadogan

LANDOWNER: Lake Smith  
212 W. Main St. - Lake Smith  
At 2. Airborne  
 (mailing address)

description of formations encountered	from	to
21' 1 1/2" clay pipe	0	27
stayed on chalk	27	35

WELL LOCATION:  
 sec. 6 T. 8 N. R. 6 E  
1 miles NE of Chaigneau  
 (distance) (direction) (nearest town)

6' 1/4" 60 ga S.S.		
--------------------	--	--

WELL PURPOSE: drain  
 (home, irrigation, municipal, industrial)

drain on case well

**WELL COMPLETION DATA:**

- diameter (inches) 2"
  - total depth (feet) 35'
  - static water level (feet) 17  below  above top of ground.
  - casing steel 2 3/4'  
 (material) (depth)  
2" if telescope see back.  
 (size)
  - screen 6' 29  
 (length) (depth to top)  
1 1/2" 60 ga S.S.  
 (size) (material)
  - pump 3/4 15  
 (HP) (yield gpm)  
elec  
 (type power)
  - electric log no  
 (yes or no)
- (organization running log)

back wash valve to		
steel funnel		

**CODING**


OCT 19 1972

DRILLERS REMARKS:

back wash valve

If well telescopes please sketch and show depths.

GROUND LEVEL

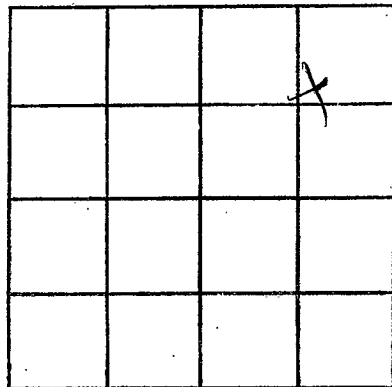

SECTION 6

Please indicate well location X.

ADDITIONAL INFORMATION

If more than one screen,  
show locations of each on sketch.