

MISSISSIPPI  
BOARD OF WATER COMMISSIONERS  
416 North State Street  
Jackson, Mississippi 39201

**CODED**

WATER WELL DRILLERS LOG

Wayne  
164  
10-2-72

Oct 2 1972 date well completed  
McILWAIN WATER WELL SER. firm name  
Wayne county well located

LANDOWNER:	description of formations encountered	from	to
PETE COCHRAN Rt 4 WAYNESBORO, Miss (mailing address)			
WELL LOCATION:	Sand	9	20
sec. 13 T 8 N R 6 E 6 miles E of WARD (distance) (direction) (nearest town)	Fine sand + Clay	25	32
WELL PURPOSE: Home (home, irrigation, municipal, industrial)	Fine sand	32	40
WELL COMPLETION DATA:	Coarse sand	40	62
(1) diameter (inches) 2"			
(2) total depth (feet) 62			
(3) static water level (feet) 54' below top of ground			
(4) casing PVC 57' (material) (depth) 2" (size) If telescope see back.			
(5) screen 5' 57' (length) (depth to top) 2" PVC .008 (size) (material)			
(6) pump 1 7 (HP) (yield gpm) 220 AC (type power)			
(7) electric log No (yes or no)			
(organization running log)			
(8) how well bottom plugged			
DRILLERS REMARKS:			


**CODED**

NOV 9 1972

MISS. DEP. OF AGRIC. & FORESTRY  
WATER RESOURCES DIVISION

If well telescopes please sketch and show depths.

GROUND LEVEL

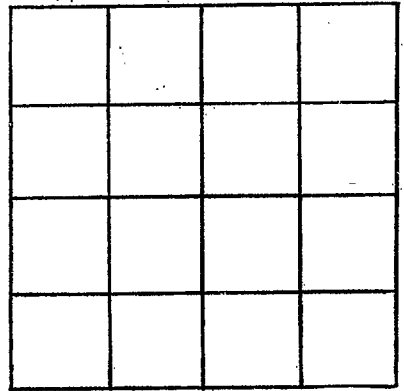

SECTION \_\_\_\_\_

Please indicate well location X.

ADDITIONAL INFORMATION

If more than one screen,  
show locations of each on sketch.