

MISSISSIPPI
BOARD OF WATER COMMISSIONERS
416 North State Street
Jackson, Mississippi 39201

WATER WELL DRILLERS LOG

CODED

Wayne
0166
11-8-72

Nov 8 1972 date well completed
19 Mc ILWAIN WATER WELL SER firm name
WAYNE county well located

LANDOWNER:
ROBERT DYESS
RT 2 WAYNESBORO, MISS.
(mailing address)

WELL LOCATION:
sec. 5 T. 8 N. R. 6 W
miles of (distance) (direction) (nearest town)

WELL PURPOSE:
(home, irrigation, municipal, industrial)

- WELL COMPLETION DATA:
- (1) diameter (inches) 2"
 - (2) total depth (feet) 44'
 - (3) static water level (feet) 20 below top of ground.
 - (4) casing GALV. 39'
(material) (depth)
2" If telescope see back.
(size)
 - (5) screen 5' 39'
(length) (depth to top)
2" PVC .008
(size) (material)
 - (6) pump 1/2 6
(HP) (yield gpm)
110 AC
(type power)
 - (7) electric log no
(yes or no)
 - (8) how well bottom plugged _____
(organization running log)

description of formations encountered	depth	
	from	to
Clay	0	5
Sand	5	8
Clay	8	21
Rock	21	21 1/2
Clay + Fine sand	21 1/2	35
Clay	35	38
Sand	38	44


CODED

DRILLERS REMARKS:

DEC 11 1972

If well telescopes please sketch and show depths.

GROUND LEVEL

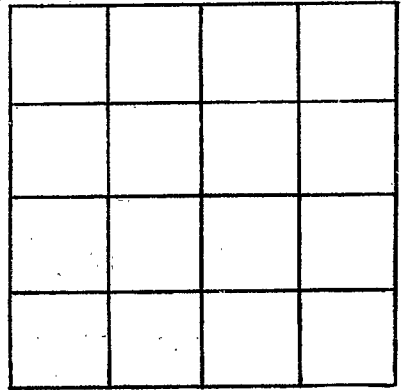

SECTION _____

Please indicate well location X.

ADDITIONAL INFORMATION

If more than one screen, show locations of each on sketch.