

BOARD OF WATER COMMISSIONERS

416 North State Street

Jackson, Mississippi 39201

WAYNE

167

12-1-72

Dec 1

WATER WELL DRILLERS LOG

CODED

1972 Bohrer Drilling & Supply Wayne
 date well completed firm name county well located

LANDOWNER: Mr. D. E. Wiley

| description of formations encountered | from | to |
|---------------------------------------|------|-----|
| clay & chalk | 0 | 24 |
| sand & chalk | 24 | 40 |
| sand | 40 | 106 |
| blue chalk | 106 | 118 |
| rock strata | 118 | 155 |
| blue chalk | 155 | 225 |
| limestone rock | 225 | 259 |

At 4 Waynesboro
 (mailing address)

WELL LOCATION:
 sec 21 T 80 N R 6 E
3 miles SE of Waynesboro
 (distance) (direction) (nearest town)

WELL PURPOSE: home
 (home, irrigation, municipal, industrial)

WELL COMPLETION DATA:

- (1) diameter (inches) 2"
- (2) total depth (feet) 259'
- (3) static water level (feet) 78 below top of ground.
- (4) casing steel 225'
 (material) (depth)
2" if telescope see back.
 (size)
- (5) screen none used
 (length) (depth to top)
 (size) (material)
- (6) pump 2 10
 (HP) (yield gpm)
elec.
 (type power)
- (7) electric log no
 (yes or no)
 (organization running log)
- (8) how well bottom plugged open

126' 1 1/4" drive pipe


CODED

DRILLERS REMARKS:

DEC 15 1972

If well telescopes please sketch and show depths.

GROUND LEVEL

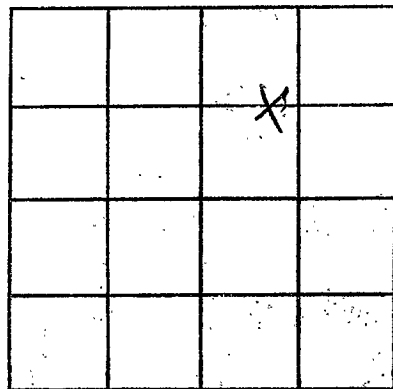

SECTION 21

Please indicate well location X.

ADDITIONAL INFORMATION

If more than one screen, show locations of each on sketch.