

Wayne
 168
 12-22-72

MISSISSIPPI
 BOARD OF WATER COMMISSIONERS
 416 North State Street
 Jackson, Mississippi 39201

CODED

WATER WELL DRILLERS LOG


12-22-72¹⁹ MS. ILWAIN WATER WELL SER. WAYNE
 date well completed firm name county well located

LANDOWNER:	description of formations encountered	from	to
RAYMOND FRAZIER Rt 2 WAYNESBORO (mailing address)			
WELL LOCATION:	CLAY	8	15
sec. 9 T. 8 N R. 6 E 2 miles E of W. BORO (distance) (direction) (nearest town)	FINE SAND + CLAY	15	45
WELL PURPOSE: HOME (home, irrigation, municipal, industrial)	SAND	45	68
WELL COMPLETION DATA:			
(1) diameter (inches) 2"			
(2) total depth (feet) 68'			
(3) static water level (feet) 34' below top of ground.			
(4) casing GALV. 63' (material) (depth) 2" (size) if telescope see back.			
(5) screen 5' 63' (length) (depth to top) 2" PVC 008 (size) (material)			
(6) pump 1/2 6 (HP) (yield gpm) 110 AC ROD PUMP (type power)			
(7) electric log NO (yes or no)			
(organization running log)			
(8) how well bottom plugged			
DRILLERS REMARKS:			

1 1/2" 0 1/2" 0 1/2"

If well telescopes please sketch and show depths.

GROUND LEVEL

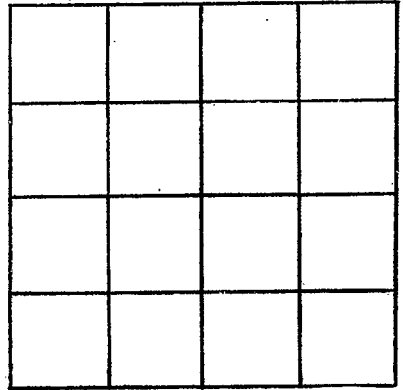

SECTION _____

Please indicate well location X.

ADDITIONAL INFORMATION

If more than one screen,
show locations of each on sketch.