

**WAYNE**  
**Φ 170**  
**7-15-74**

MISSISSIPPI  
 BOARD OF WATER COMMISSIONERS  
 416 North State Street  
 Jackson, Mississippi 39201

**CODED**

**WATER WELL DRILLERS LOG**

**McILWAIN WATER WELL SERVICE**

*WAYNE*

*July 15, 1974*  
 date well completed

RT. 4 firm route 37

county well located

WAYNE SB. RO. MISS. 39367

**LANDOWNER:**

*Rudolph Evans*

*Rt 2 Waynesboro, Miss*  
 (mailing address)

**description of formations encountered**

from

to

*RED CLAY*

*0*

*4*

*WHITE CLAY*

*4*

*16*

*SAND & CLAY*

*16*

*22*

*SAND*

*22*

*54*

**WELL LOCATION:**

sec. *1* T. *8* N R. *6* W  
*6* miles *E* of *W'boro*  
 (distance) (direction) (nearest town)

**WELL PURPOSE:** *HOME*  
 (home, irrigation, municipal, industrial)

**WELL COMPLETION DATA:**

- (1) diameter (inches) *2"*
- (2) total depth (feet) *54'*
- (3) static water level (feet) *37'* below top of ground.
- (4) casing *PVC*, *49'*  
 (material) (depth)  
*2"* if telescope see back.  
 (size)
- (5) screen *5'*, *49'*  
 (length) (depth to top)  
*2"*, *PVC*, *.008*  
 (size) (material)
- (6) pump *3/4*, *10*  
 (HP) (yield gpm)  
*110 AC*  
 (type power)
- (7) electric log *710*  
 (yes or no)

(organization running log)

(8) how well bottom plugged

**DRILLERS REMARKS:**

**CODED**


**RECEIVED**

**AUG 13 1974**

**MISS. BD. OF WATER COMMISSIONERS**

If well telescopes please sketch and show depths.

GROUND LEVEL

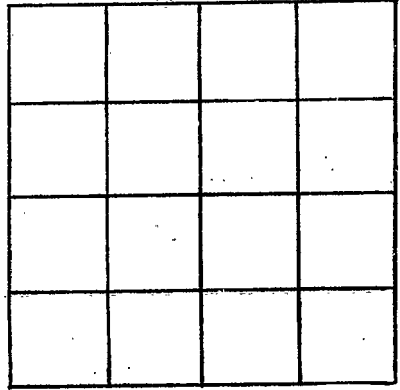

SECTION \_\_\_\_\_

Please indicate well location X.

ADDITIONAL INFORMATION

If more than one screen, show locations of each on sketch.