

WAYNE
0172
1-3-73

MISSISSIPPI
BOARD OF WATER COMMISSIONERS
416 North State Street
Jackson, Mississippi 39201

CODED

WATER WELL DRILLERS LOG

Jan 3 1973 Rison Water Well Dr. Wayne
date well completed firm name county well located

LANDOWNER: Robert West
Wynnesboro, Miss
(mailing address)

description of formations encountered	from	to
Top Soil	0	2
Red Clay	2	12
White Fine Sand	12	18
Blue & white chert	18	62
Fine sand	62	85
Blue chert	85	90
Coarse sand & gravel	90	105
Total	105	Feet

WELL LOCATION:
sec. 23 T. 8 N. R. 6 E.
S. W.
6 miles South of Wynnesboro
(distance) (direction) (nearest town)

WELL PURPOSE: Home
(home, irrigation, municipal, industrial)

WELL COMPLETION DATA:
(1) diameter (inches) 4"
(2) total depth (feet) 105'
(3) static water level (feet) 65' below above top of ground.
(4) casing 2" 102'
(material) (depth)
(size) if telescope see back.
(5) screen 3' 185'
(length) (depth to top)
1 1/2" Strandless Steel
(size) (material)
(6) pump 1 9
(HP) (yield gpm)
Electric
(type power)
(7) electric log no.
(yes or no)
(organization running log)
(8) how well bottom plugged Drive-Point


CODED

DRILLERS REMARKS: Good

MAR 8 1973

If well telescopes please sketch and show depths.

GROUND LEVEL

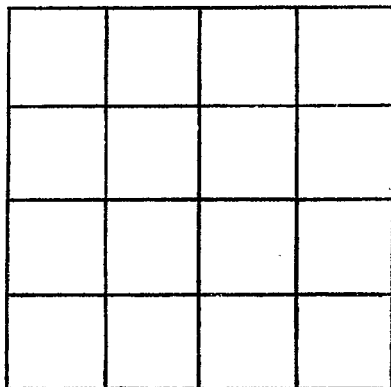

SECTION _____

Please indicate well location X.

ADDITIONAL INFORMATION

Lined area for additional information, consisting of multiple horizontal lines.

If more than one screen, show locations of each on sketch.